

MISSISSIPPI
BOARD OF WATER COMMISSIONERS
416 North State Street
Jackson, Mississippi 39201

CODED

WATER WELL DRILLERS LOG

UNION
J45
11-5-73

Nov 5 1973 date well completed
J.W. Webb & Sons firm name
Union county well located

LANDOWNER: Dennis Rakestraw
Blue Springs
(mailing address)

description of formations encountered	from	to
Soil	0	1
Sand & Clay	1	190
Blue Rock	190	461
Water Rock	461	463
Water sand	463	565
Coffee Sand		

WELL LOCATION:
sec. 9 T. 15 N R. 4 E
6 miles west of Elliottown
(distance) (direction) (nearest town)

WELL PURPOSE:
(home, irrigation, municipal, industrial)

- WELL COMPLETION DATA:
- (1) diameter (inches) 4"
 - (2) total depth (feet) 565 ft
 - (3) static water level (feet) 207 below top of ground.
 - (4) casing steel, 201 ft
(material) (depth)
4" If telescope see back.
(size)
 - (5) screen 0, 0
(length) (depth to top)
(size) (material)
 - (6) pump 3/4 Sub, 8
(HP) (yield gpm)
Elec
(type power)
 - (7) electric log _____
(yes or no)
(organization running log)
 - (8) how well bottom plugged _____


CODED

DRILLERS REMARKS:

MISS. BO. OF WATER COM.

If well telescopes please sketch and show depths.

GROUND LEVEL

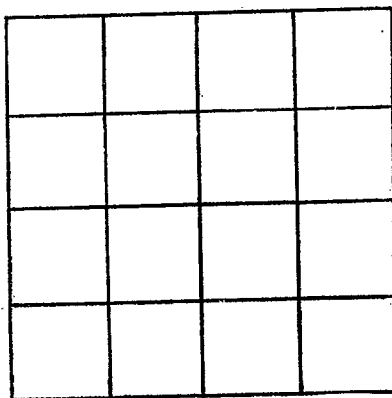

SECTION _____

Please indicate well location X.

ADDITIONAL INFORMATION

If more than one screen, show locations of each on sketch.