

UNION
J46
620-74

MISSISSIPPI
BOARD OF WATER COMMISSIONERS
416 North State Street
Jackson, Mississippi 39201

CODED

WATER WELL DRILLERS LOG

Herman Homan Well & Supply, Inc.
P. O. Box 42

SHANNON, MISSISSIPPI 38868

UNION
county well located

6/20 1974
date well completed

LANDOWNER:

Beach Springs Baptist Church
Rt 3, Blue Springs, Miss
(mailing address)

description of formations encountered

from to

description of formations encountered	from	to
surface sand & clay	0	16
blue clay	16	160
sand	160	300
Other	300	

WELL LOCATION:

sec. 32 T 2 N R 5 E
S W
1 1/2 miles S of BRANFAN
(distance) (direction) (nearest town)

WELL PURPOSE: church
(home, irrigation, municipal, industrial)

WELL COMPLETION DATA:

- (1) diameter (inches) 4"
- (2) total depth (feet) 300
- (3) static water level (feet) 58' below top of ground.
- (4) casing steel, 2 1/4"
(material) (depth)
if telescope see back.
- (5) screen no
(length) (depth to top)
(size) (material)
- (6) pump 1 5
(HP) (yield gpm)
electric
(type power)
- (7) electric log no
(yes or no)
(organization running log)
- (8) how well bottom plugged open


CODED

RECEIVED
JUN 21 1974

DRILLERS REMARKS:

If well telescopes please sketch and show depths.

GROUND LEVEL

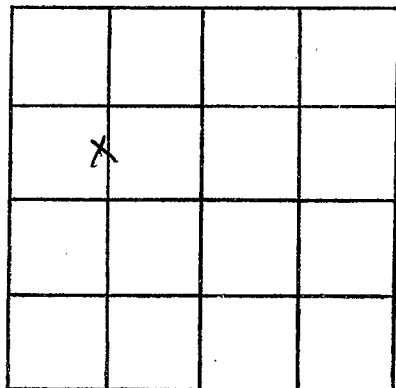

SECTION 32

Please indicate well location X.

ADDITIONAL INFORMATION

If more than one screen,
show locations of each on sketch.