

UNION  
 J 47  
 7-9-74

MISSISSIPPI  
 BOARD OF WATER COMMISSIONERS  
 416 North State Street  
 Jackson, Mississippi 39201

CODED

WATER WELL DRILLERS LOG

July 9 1974 G. W. W. Whorton Union  
 date well completed firm name county well located

LANDOWNER: G. C. Keller  
 Blue Springs  
 Ellipton, Miss.  
 (mailing address)

description of formations encountered	from	to
soil	0	1
Clay & Shales	1	35
Blue Rock	35	277
Males Rock	279	283
Water sand	283	480
Coarse sand		

WELL LOCATION:  
 sec. 19 T. 75 N. R. 5 E  
 2 miles East of Ellipton  
 (distance) (direction) (nearest town)

WELL PURPOSE:  
 (home, irrigation, municipal, industrial)

- WELL COMPLETION DATA:
- (1) diameter (inches) 5"
  - (2) total depth (feet) 400
  - (3) static water level (feet) 154 below above top of ground.
  - (4) casing Steel 4 1/2"  
 (material) (depth)  
5' If telescope see back.  
 (size)
  - (5) screen 0 C  
 (length) (depth to top)  
 (size) (material)
  - (6) pump 1/2 HP sub 8  
 (HP) (yield gpm)  
Elec  
 (type power)
  - (7) electric log (yes or no) \_\_\_\_\_  
 (organization running log) \_\_\_\_\_
  - (8) how well bottom plugged \_\_\_\_\_

CODED


RECEIVED  
 AUG - 8 1974

DRILLERS REMARKS:

MISS. BD. OF WATER COMMISSIONERS

If well telescopes please  
sketch and show depths.

GROUND LEVEL

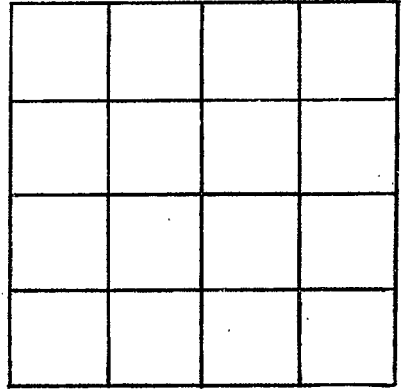

SECTION \_\_\_\_\_

Please indicate well location X.

ADDITIONAL INFORMATION

If more than one screen,  
show locations of each on sketch.