

UNION  
 J48  
 10/75  
 Elm #32

MISSISSIPPI  
 BOARD OF WATER COMMISSIONERS  
 416 North State Street  
 Jackson, Mississippi 39201  
 MS-OW-00251  
 WATER WELL DRILLERS LOG

10/75

October 19 75 Herndon Well & Supply, Inc. Union  
 date well completed firm name county well located

LANDOWNER:	description of formations encountered	from	to
Blue Springs Water Association, Inc.	Red Clay	0	8
Blue Springs, MS (mailing address)	Sand	8	18
Blue Springs, MS (mailing address)	Blue Rock	18	60
Blue Springs, MS (mailing address)	Lime Rock	60	300
WELL LOCATION:	Hard Rock	300	301
sec. 26 T. 7 S. R. 4 E. (distance) (direction) (nearest town)	Sand	301	356
inside Blue Springs (distance) (direction) (nearest town)	Lime Rock	356	410
WELL PURPOSE: Association (home, irrigation, municipal, industrial)	Rock	410	411
WELL COMPLETION DATA:	Lime Rock	411	430
(1) diameter (inches) 8 x 4	Rock	430	431
(2) total depth (feet) 770	Lime Rock	431	630
(3) static water level (feet) 125 below top of ground. (xxx)	Rock	630	631
(4) casing Steel, 710' (material) (depth)	Fine Sand	631	690
8" (size) If telescope see back.	Clay	690	705
(5) screen 60' - 710' (length) (depth to top)	Sand	705	778
4" Stainless Steel (size) (material)	Clay	778	798
(6) pump 30 (HP) 167 (yield gpm)	Sand and Shale Rock	798	835
Elec. (type power)	Hard Rock - White	835	860
(7) electric log Yes (yes or no)			
USGS (organization running log)			
(8) how well bottom plugged 4" Bronze BWV			
DRILLERS REMARKS:			


MISSISSIPPI BOARD OF WATER COMMISSIONERS

OCT 28 1975

MISSISSIPPI BOARD OF WATER COMMISSIONERS

(X)

If well telescopes please sketch and show depths.

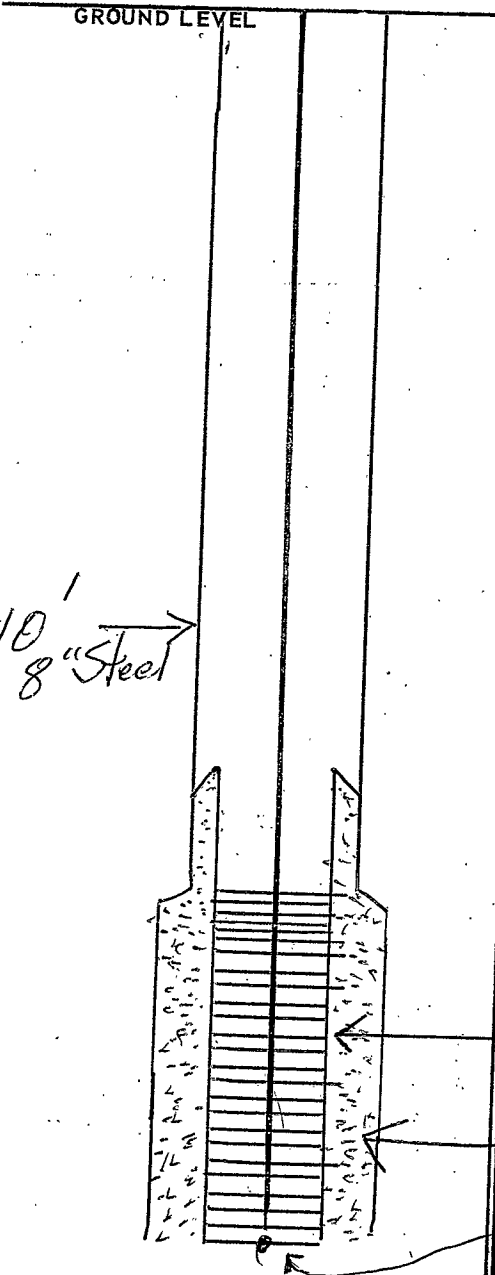

			X

SECTION 26

Please indicate well location X.

ADDITIONAL INFORMATION

Top of Dip 625'

Top of Screen 710'

4" 35 @ .025

6" CUYD Gravel

4" Bronze

If more than one screen, show locations of each on sketch.