

Need distance from nearest town

Union  
J 2001  
2-15-75

MISSISSIPPI  
BOARD OF WATER COMMISSIONERS  
416 North State Street  
Jackson, Mississippi 39201

WATER WELL DRILLERS LOG

2-15-1975 *Leeper* *Union*  
date well completed firm name county well located

LANDOWNER:	description of formations encountered	from	to
C. P. Richey	Red clay + Rock	0	20
<i>Rt 2 Blue Springs, Miss</i> (mailing address)	Red Sand	20	30
	Red sand + Rock	30	80
	Strakes Clay + Sand	80	150
	Blue Clay	150	220
	Blue clay + Rock	220	300
	Blue clay + Chalk	300	500
	Sand	500	620

WELL LOCATION:  
sec. 4 T. 7 N. R. 5 E  
S.     
(distance) miles (direction) of (nearest town)

WELL PURPOSE: Home  
(home, irrigation, municipal, industrial)

WELL COMPLETION DATA:

(1) diameter (inches) 4

(2) total depth (feet) 620

(3) static water level (feet) 180 below/above top of ground.

(4) casing Steel, 190'  
(material) (depth)  
4 if telescope see back.  
(size)

(5) screen Open,  
(length) (depth to top)  
(size) (material)

(6) pump 3/4 10  
(HP) (yield gpm)  
Elect  
(type power)

(7) electric log no  
(yes or no)

(organization running log)


(8) how well bottom plugged

DRILLERS REMARKS:

RECEIVED  
APR 27 1978  
MISS. Bd. OF WATER COMMISSIONERS

If well telescopes please sketch and show depths.

GROUND LEVEL

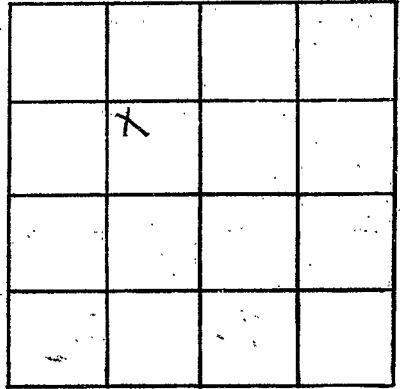

SECTION 4

Please indicate well location X.

ADDITIONAL INFORMATION

If more than one screen, show locations of each on sketch.