

UNION
J 2003
12-19-76

MISSISSIPPI
 BOARD OF WATER COMMISSIONERS
 416 North State Street
 15F Jackson, Mississippi 39201

WATER WELL DRILLERS LOG

12-19-76 19 MediWell Drilling UNION
 date well completed firm name county well located

LANDOWNER:
GEORGE MOORE
New Albany
 (mailing address)

description of formations encountered	from	to
<u>clay</u>	<u>0</u>	<u>70</u>
<u>clay & sand</u>	<u>70</u>	<u>760</u>
<u>blue mud</u>	<u>160</u>	<u>600</u>
<u>sand & rock</u>	<u>600</u>	<u>670</u>

WELL LOCATION:
 sec. 8 T. 7 N. R. 4 E
6 miles East of New Albany
 (distance) (direction) (nearest town)

WELL PURPOSE:
 home irrigation, municipal, industrial

WELL COMPLETION DATA:
 (1) diameter (inches) 4
 (2) total depth (feet) 670
 (3) static water level (feet) 160 ^{below} above top of ground.
 (4) casing 340 P/AS
 (material) (depth)
 _____ if telescope see back.
 (size)
 (5) screen _____
 (length) (depth to top)
 (size) (material)
 (6) pump 3/4 9
 (HP) (yield gpm)
Elec.
 (type power)
 (7) electric log (yes or no) _____

 (organization running log)
 (8) how well bottom plugged _____

DRILLERS REMARKS:


RECEIVED

MAY 13 1977

MISS. BD. OF WATER COMM

If well telescopes please sketch and show depths.

GROUND LEVEL

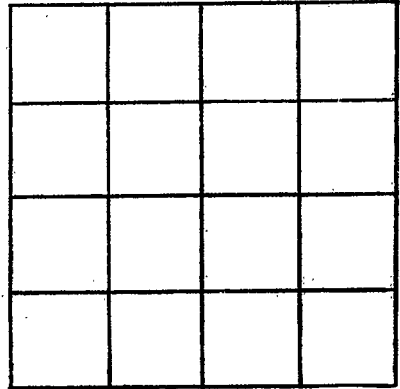

SECTION _____

Please indicate well location X.

ADDITIONAL INFORMATION

If more than one screen,
show locations of each on sketch.