

UNION
J 2004
2/11/77

MISSISSIPPI
BOARD OF WATER COMMISSIONERS
416 North State Street
15F Jackson, Mississippi 39201

WATER WELL DRILLERS LOG

2/11 1977 Medlin Well Drilling UNION
date well completed firm name county well located

LANDOWNER: Jerry Moore
New Albany Ms
(mailing address)

description of formations encountered	from	to
0 to 30 Clay	0	30
30 to 43 Blue Clay	30	240
Sand + Rock	240	280

WELL LOCATION:
sec. 7 T 7 N R. 4 E
7.5 miles EAST of New Albany
(distance) (direction) (nearest town)

WELL PURPOSE:
(home, irrigation, municipal, industrial)

- WELL COMPLETION DATA:
- (1) diameter (inches) 4"
 - (2) total depth (feet) 280'
 - (3) static water level (feet) 180' ^{below} above top of ground.
 - (4) casing PLAS. 280'
(material) (depth)
 - 0/0 If telescope see back.
(size)
 - (5) screen 10' 270'
(length) (depth to top)
4" PLAS.
(size) (material)
 - (6) pump 3/4 8
(HP) (yield gpm)
Elec.
(type power)
 - (7) electric log (yes or no)
 - (organization running log)
 - (8) how well bottom plugged Plastic CAP.


DRILLERS REMARKS:

RECEIVED
AUG 22 1977

MISS. BD. OF WATER COMMISSIONERS

If well telescopes please sketch and show depths.

GROUND LEVEL

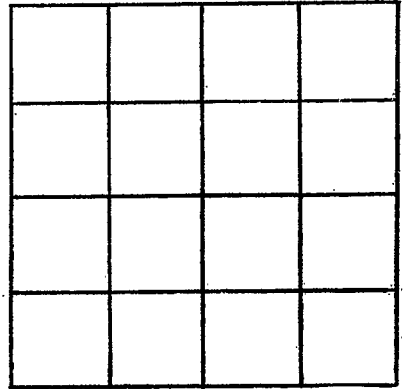

SECTION _____

Please indicate well location X.

ADDITIONAL INFORMATION

If more than one screen, show locations of each on sketch.