

MISSISSIPPI DEPARTMENT OF NATURAL RESOURCES

Bureau of Land and Water Resources

Southport Mall

P.O. Box 10631

Jackson, Mississippi 39209

WATER WELL DRILLERS LOG

Union
T2008

6 15 1983
date well completed

Medlin
firm name

Union
county well located

LANDOWNER:	description of formations encountered	from	to
<u>Danny Hall</u>			
<u>King 348</u> (mailing address)	<u>Clay</u>	<u>120</u>	<u>285</u>
WELL LOCATION: sec. <u>22</u> T <u>7</u> N R <u>4</u> E <u>3</u> miles <u>N.W.</u> of <u>Ellistown</u> (distance) (direction) (nearest town)	<u>Shell + Blue clay</u>	<u>285</u>	<u>385</u>
WELL PURPOSE: (home, irrigation, municipal, industrial)	<u>Rock + shell + clay</u>	<u>385</u>	<u>495</u>
WELL COMPLETION DATA: (1) diameter (inches) <u>4</u>	<u>Clay</u>	<u>495</u>	<u>580</u>
(2) total depth (feet) <u>580</u>			
(3) static water level (feet) <u>330</u> Below top of ground.			
(4) casing <u>PVC</u> <u>400</u> (material) (depth)			
(size) If telescope see back.			
(5) screen (length) (depth to top)			
(size) (material)			
(6) pump <u>1 hp</u> <u>10</u> (HP) (yield gpm)			
<u>Ele.</u> (type power)			
(7) electric log (yes or no)			
(organization running log)			
(8) how well bottom plugged <u>0</u>			
DRILLERS REMARKS:			


DEPT. OF NATURAL RESOURCES
BUREAU OF LAND & WATER RESOURCES

AUG 4 1983

RECEIVED

If well telescopes please sketch and show depths.

GROUND LEVEL

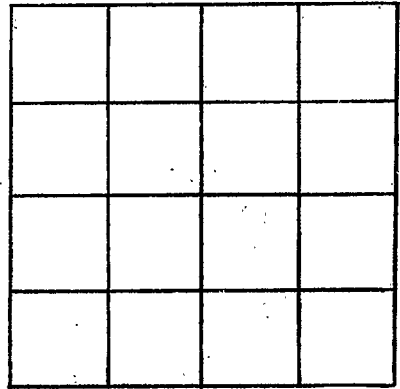

SECTION _____

Please indicate well location X.

ADDITIONAL INFORMATION

If more than one screen,
show locations of each on sketch.