

DEC 18 1968

CODED

MISSISSIPPI BOARD OF WATER COMMISSIONER

MISS. BD. OF

416 North State Street

Jackson, Mississippi 39201

CODED

WATER WELL DRILLERS LOG

Union
R 4
12-5-68

12-5-68 date well completed 1968 Clark Bros. firm name Union county well located

LANDOWNER: Silly F. Putney

description of formations encountered

from to

R4-1 Etta
(mailing address)

<u>Shunk</u>	0	16
<u>Rock & Sand</u>	16	70
<u>Blue mud</u>	70	350
<u>Rock & Sand</u>	350	400

WELL LOCATION:

sec. 10 T. 8 N. R. 1 E
20 miles S-W of New Albany
(distance) (direction) (nearest town)

WELL PURPOSE: Home
(home, irrigation, municipal, industrial)

WELL COMPLETION DATA:

- (1) diameter (inches) 4"
- (2) total depth (feet) 400'
- (3) static water level (feet) 60' below above top of ground.
- (4) casing Metal, 90'
(material) (depth)
4" if telescope see back.
(size)
- (5) screen None
(length) (depth to top)
(size) (material)
- (6) pump 1/2 Gal. 10
(HP) (yield gpm)
Electric
(type power)
- (7) electric log NO
(yes or no)
(organization running log)
- (8) how well bottom plugged NO


CODED

CODED

DRILLERS REMARKS:

If well telescopes please sketch and show depths.

GROUND LEVEL

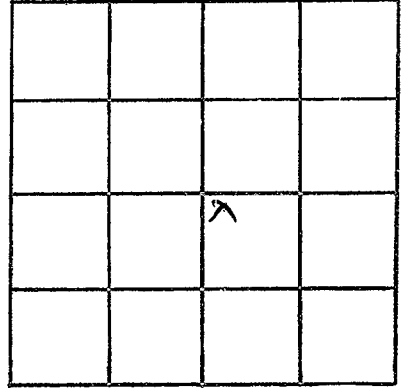

SECTION 10

Please indicate well location X.

ADDITIONAL INFORMATION

If more than one screen,
show locations of each on sketch.