

Union.
K5
12-68

MISSISSIPPI
BOARD OF WATER COMMISSIONERS
416 North State Street
Jackson, Mississippi 39201

CODED

CODED

WATER WELL DRILLERS LOG

12-17 1968 date well completed
 68 Clark Bros. firm name
 Union county well located

LANDOWNER: Billy Rutledge

description of formations encountered	from	to
<u>Shumbo</u>	<u>0</u>	<u>20</u>
<u>Rock & Sand</u>	<u>20</u>	<u>80</u>
<u>Blue mud</u>	<u>80</u>	<u>330</u>
<u>Rock & Sand</u>	<u>330</u>	<u>400</u>

Pinedale, Miss
(mailing address)

WELL LOCATION:
 sec. 11 T. 8 N. R. 1 E
12 miles SW of New Albany
 (distance) (direction) (nearest town)

WELL PURPOSE: Home
 (home, irrigation, municipal, industrial)

- WELL COMPLETION DATA:
- diameter (inches) 4"
 - total depth (feet) 400'
 - static water level (feet) 60' below above top of ground.
 - casing Metal, 90'
 (material), (depth)
4"
 (size) if telescope see back.
 - screen None
 (length), (depth to top)
 (size), (material)
 - pump 1/2 Sub. 8
 (HP) (yield gpm)
Electric
 (type power)
 - electric log no
 (yes or no)
 (organization running log)
 - how well bottom plugged no


CODED

DRILLERS REMARKS:

MISS. BD. OF WATER COMMISSIONERS
 JAN 10 1969

If well telescopes please sketch and show depths.

GROUND LEVEL

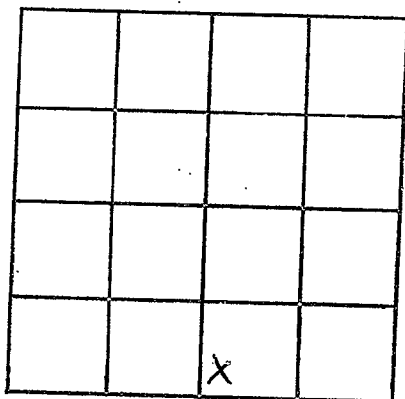

SECTION _____

Please indicate well location X.

ADDITIONAL INFORMATION

If more than one screen,
show locations of each on sketch.