

Union
K6
5-27-69

MISSISSIPPI
BOARD OF WATER COMMISSIONERS
416 North State Street
Jackson, Mississippi 39201

CODED

WATER WELL DRILLERS LOG

5-27-69 19 LAMAR WILDER UNION
date well completed firm name county well located

LANDOWNER:
SAMMY MONTGOMERY
RT-4 - NEW ALBANY
(mailing address)

WELL LOCATION:
sec. 9 T. 3 S. R. 1 E.
2 miles SW of RIVERDALE
(distance) (direction) (nearest town)

| description of formations encountered | from | to |
|---------------------------------------|------------|------------|
| <u>RED CLAY</u> | <u>0</u> | <u>20</u> |
| <u>BLACK CLAY</u> | <u>20</u> | <u>40</u> |
| <u>BLUE SHALE</u> | <u>115</u> | <u>140</u> |
| <u>LIME STONE</u> | <u>140</u> | <u>150</u> |
| <u>BLUE SHALE</u> | <u>150</u> | <u>450</u> |

WELL PURPOSE: HOME
(home, irrigation, municipal, industrial)

WELL COMPLETION DATA:

(1) diameter (inches) 4

(2) total depth (feet) 572

(3) static water level (feet) X below above top of ground.

(4) casing STEEL, 168,
(material) (depth)
 if telescope see back.
(size)

(5) screen ,
(length) (depth to top)
 ,
(size) (material)

(6) pump PUMP 3V
(HP) (yield gpm)
OT HELS
(type power)

(7) electric log
(yes or no)

(organization running log)

(8) how well bottom plugged

CODED


DOWN 4 - 1969

DRILLERS REMARKS:

MISS. RD. OF
WATER COMM.

If well telescopes please sketch and show depths.

GROUND LEVEL

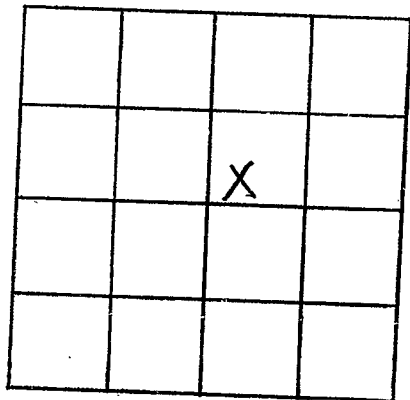

SECTION 9

Please indicate well location X.

ADDITIONAL INFORMATION

If more than one screen, show locations of each on sketch.