

Union Co  
K 7  
7-69

MISSISSIPPI  
BOARD OF WATER COMMISSIONERS  
416 North State Street  
Jackson, Mississippi 39201

CODED

WATER WELL DRILLERS LOG

7-9 1969 date well completed  
Clark Bros. firm name  
Union county well located

LANDOWNER:  
J. C. Bateman  
Etta Route 1  
(mailing address)

description of formations encountered	from	to
Shingles	0	18
Rock & sand	18	63
Blue mud	63	263
Rock & sand	263	300
Blue mud	300	380
Rock & sand	380	440

WELL LOCATION:  
sec. 34 T 8 N R. 1 E  
6 miles SW of Etta  
(distance) (direction) (nearest town)

WELL PURPOSE: Home  
(home, irrigation, municipal, industrial)

WELL COMPLETION DATA:

- (1) diameter (inches) 4
- (2) total depth (feet) 440
- (3) static water level (feet) 20 below top of ground.
- (4) casing metal, 92 (material) (depth)  
4 (size) if telescope see back.
- (5) screen None (length) (depth to top)  
(size) (material)
- (6) pump (HP) (yield gpm)  
Electric (type power)
- (7) electric log no (yes or no)  
(organization running log)
- (8) how well bottom plugged no


DRILLERS REMARKS:

AUG 7 1969

MISS. BD. OF  
WATER COM.

If well telescopes please sketch and show depths.

GROUND LEVEL

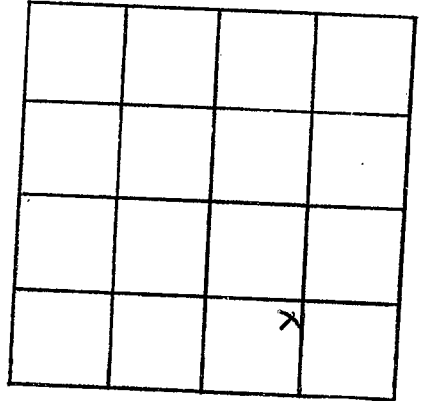

SECTION \_\_\_\_\_

Please indicate well location X.

ADDITIONAL INFORMATION

If more than one screen,  
show locations of each on sketch.