

Union
K 8
5-16-69

MISSISSIPPI
BOARD OF WATER COMMISSIONERS
416 North State Street
Jackson, Mississippi 39201

CODED

WATER WELL DRILLERS LOG

5-16 1969 Clark Bros Union
date well completed firm name county well located

LANDOWNER:

Alton Halden
Etta - RT
(mailing address)

description of formations
encountered

from to

Shunk	0	30
Sand	30	70
Blue mud	70	110
Rock	110	115
Blue mud	115	265
Rock & Sand	265	462

WELL LOCATION:

sec. 11 T 8 N R 1 E
S-W miles 15 of South Bay
(distance) (direction) (nearest town)

WELL PURPOSE: Home
(home, irrigation, municipal, industrial)

WELL COMPLETION DATA:

- diameter (inches) 4"
- total depth (feet) 462'
- static water level (feet) 90' below top of ground.
- casing Metal 111' (material), (depth)
4" (size) if telescope see back.
- screen none (length), (depth to top)
(size), (material)
- pump 1/2 Sub 8 (HP), (yield gpm)
Electric (type power)
- electric log no (yes or no)
(organization running log)
- how well bottom plugged no


JUN 2 - 1969

MISS. BD. OF
WATER COMMISSIONERS

DRILLERS REMARKS:

If well telescopes please sketch and show depths.

GROUND LEVEL

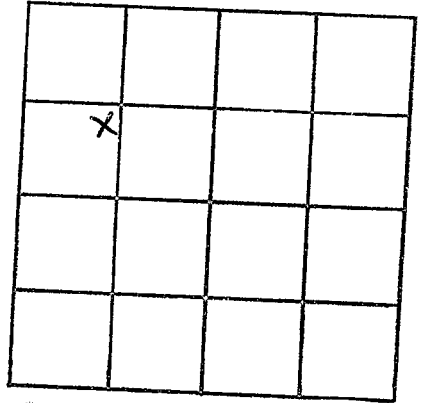

SECTION 11

Please indicate well location X.

ADDITIONAL INFORMATION

If more than one screen,
show locations of each on sketch.