

Union
R9
12-12-69

MISSISSIPPI
BOARD OF WATER COMMISSIONERS
416 North State Street
Jackson, Mississippi 39201

CODED

CODED

WATER WELL DRILLERS LOG

12-12-1969 date well completed
Clark Bros firm name
Union county well located

LANDOWNER:

W.C. New
Etta
(mailing address)

description of formations encountered

from to

Shale	0	15
Rock & Sand	15	60
Blue mud	60	260
Rock & Sand	260	250
Blue mud	250	350
Rock & sand	350	400

WELL LOCATION:

sec. 2 T. 8 N R. 1 E
14 miles S-W of Pearl River
(distance) (direction) (nearest town)

WELL PURPOSE: Home
(home, irrigation, municipal, industrial)

WELL COMPLETION DATA:

- (1) diameter (inches) 4"
- (2) total depth (feet) 400'
- (3) static water level (feet) 50' below top of ground.
- (4) casing Metal, 105' (material) (depth)
4" (size) if telescope see back.
- (5) screen none (length) (depth to top)
- (6) pump 1 set (HP) 5 (yield gpm)
Electric (type power)
- (7) electric log no (yes or no)
- (8) how well bottom plugged NO


DRILLERS REMARKS:

JAN 5 1970

MISS. BD. OF
WATER COMMISSIONERS

If well telescopes please sketch and show depths.

GROUND LEVEL

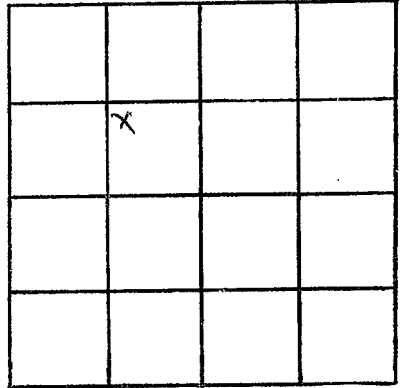

SECTION 2

Please indicate well location X.

ADDITIONAL INFORMATION

If more than one screen, show locations of each on sketch.