

Union
K 10
7-30-70

MISSISSIPPI
BOARD OF WATER COMMISSIONERS
416 North State Street
Jackson, Mississippi 39201

CODED

WATER WELL DRILLERS LOG

4 30 19 70 date well completed
J T Madlin firm name
UNION county well located

LANDOWNER: Libby June Hall
Pinedale

| description of formations encountered | from | to |
|---------------------------------------|------|-----|
| Red clay | 0 | 17 |
| SAND | 17 | 23 |
| Yellow " | 23 | 31 |
| Blue | 31 | 470 |
| ROCK | 470 | 478 |
| Blue clay | 478 | 498 |
| ROCK | 498 | 503 |
| SAND | 503 | 508 |
| Blue " | 508 | 523 |
| SAND | 523 | 573 |
| Blue | 573 | 580 |

(mailing address)

WELL LOCATION:
sec. 8 T. 8 N. R. 1 E
15 miles West of Pinedale
(distance) (direction) (nearest town)

WELL PURPOSE:
(home, irrigation, municipal, industrial)

WELL COMPLETION DATA:

- (1) diameter (inches) 4
- (2) total depth (feet) 580
- (3) static water level (feet) 106 below above top of ground.
- (4) casing P 132
(material) (depth)
(size) if telescope see back.
- (5) screen
(length) (depth to top)
(size) (material)
- (6) pump L 4
(HP) (yield gpm)
E
(type power)
- (7) electric log (yes or no)
(organization running log)
- (8) how well bottom plugged Blue clay

CODED


AUG - 3 1970

MISS. BD. OF
WATER

DRILLERS REMARKS:

If well telescopes please
sketch and show depths.

GROUND LEVEL

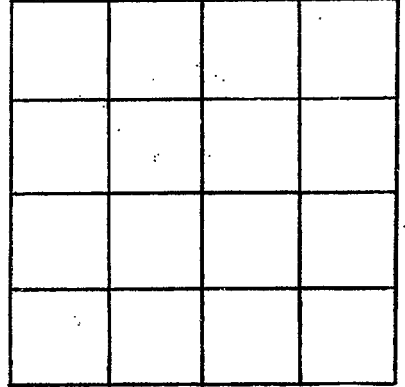

SECTION _____

Please indicate well location X.

ADDITIONAL INFORMATION

If more than one screen,
show locations of each on sketch.