

UNION
K 11
9-18-70

MISSISSIPPI
BOARD OF WATER COMMISSIONERS
416 North State Street
Jackson, Mississippi 39201

CODED

WATER WELL DRILLERS LOG

9 1/2 1970 J.T. Modlin UNION
date well completed firm name county well located

LANDOWNER: L.R. Bogue

description of formations encountered

from to

Pinedale

CLAY	"	0	17
SAND		17	25
Blue		25	333
ROCK		333	341
Blue	CLAY	341	362
ROCK		362	369
SAND		369	419
Blue		419	430

(mailing address)

WELL LOCATION:

sec. 15 T 8 N R 1 E
2 miles S of Pinedale
(distance) (direction) (nearest town)

WELL PURPOSE:

(home, irrigation, municipal, industrial)

WELL COMPLETION DATA:

- (1) diameter (inches) 4
- (2) total depth (feet) 430
- (3) static water level (feet) 20 below top of ground
- (4) casing P 100 (material) (depth)
if telescope see back. (size)
- (5) screen 26 410 (length) (depth to top)
(size) (material)
- (6) pump 1 HP 6 (HP) (yield gpm)
E (type power)
- (7) electric log (yes or no)
(organization running log)
- (8) how well bottom plugged

CODED


OCT 7 1970

DRILLERS REMARKS:

MISS. BD. OF
WATER COMMISSIONERS

If well telescopes please sketch and show depths.

GROUND LEVEL

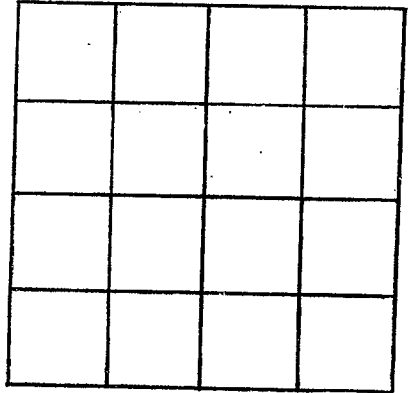

SECTION _____

Please indicate well location X.

ADDITIONAL INFORMATION

If more than one screen,
show locations of each on sketch.