

CODED

MISSISSIPPI
BOARD OF WATER COMMISSIONERS
416 North State Street
Jackson, Mississippi 39201

WATER WELL DRILLERS LOG

UNION
K12
8-3-70

Aug 3 1970 J.T. Medina W.M.B. county well located
date well completed firm name

LANDOWNER: Olthoff
Dillard Pinedale
(mailing address)

description of formations encountered	from	to
	Clay	0
Blue "	13	360
Rock	360	366
Blue clay	366	378
Rock	378	384
Sand	384	410
Blue "	410	426
Sand	426	458
Blue "	458	480

WELL LOCATION:
sec. 8 T 4 N. R. 1 E
12 miles E of Pinedale
(distance) (direction) (nearest town)

WELL PURPOSE:
(home, irrigation, municipal, industrial)

WELL COMPLETION DATA:

(1) diameter (inches) 4

(2) total depth (feet) 480

(3) static water level (feet) 100 below above top of ground.

(4) casing P 130
(material) (depth)
(size) If telescope see back.

(5) screen 0
(length) (depth to top)
(size) (material)

(6) pump 1 4
(HP) (yield gpm)
E
(type power)

(7) electric log (yes or no)

(organization running log)

(8) how well bottom plugged open

CODED


AUG 18 1970

DRILLERS REMARKS:

CHIEF, DIV. OF
PUBLIC UTILITIES

If well telescopes please sketch and show depths.

GROUND LEVEL

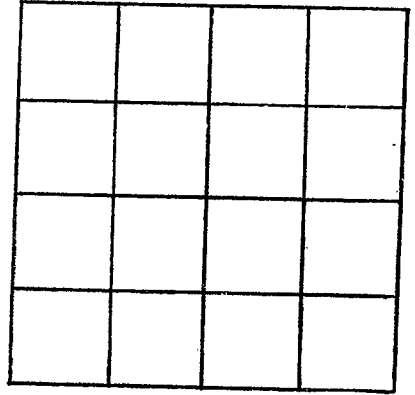

SECTION _____

Please indicate well location X.

ADDITIONAL INFORMATION

If more than one screen, show locations of each on sketch.