

Union  
K-0014  
7-20-71

MISSISSIPPI  
 BOARD OF WATER COMMISSIONERS  
 416 North State Street  
 Jackson, Mississippi 39201

\$ 713 00  
 \$ 37 00  
 \$ 750 00

WATER WELL DRILLERS LOG

**CODED**

720 1971 J T Modlin Union  
 date well completed firm name county well located

LANDOWNER:	description of formations encountered	from	to
<u>Mrs Weaver</u>	<u>White Clay</u>	<u>0</u>	<u>12</u>
<u>Papason</u>	<u>Yellow "</u>	<u>12</u>	<u>18</u>
<u>R#1 Ella</u>	<u>" Sand</u>	<u>18</u>	<u>25</u>
(mailing address)	<u>Blue Clay</u>	<u>25</u>	<u>430</u>
	<u>Rock + sand</u>	<u>430</u>	<u>500</u>

**WELL LOCATION:**  
 sec. 8 T. 8 N. R. 1 E. W Pineville  
1/2 miles W. of Pineville  
 (distance) (direction) (nearest town)

**WELL PURPOSE:**  
 (home, irrigation, municipal, industrial)

- WELL COMPLETION DATA:**
- (1) diameter (inches) 4
  - (2) total depth (feet) 500
  - (3) static water level (feet) 120 below top of ground.
  - (4) casing P 100  
(material) (depth)  
(size) If telescope see back.
  - (5) screen \_\_\_\_\_  
(length) (depth to top)  
(size) (material)
  - (6) pump 1/2 5  
(HP) (yield gpm)  
E  
(type power)
  - (7) electric log \_\_\_\_\_  
(yes or no)  
(organization running log)
  - (8) how well bottom plugged \_\_\_\_\_

**CODED**


AUG 4 - 1971

MISS. BD. OF  
WATER COMM.

DRILLERS REMARKS:

If well telescopes please sketch and show depths.

GROUND LEVEL

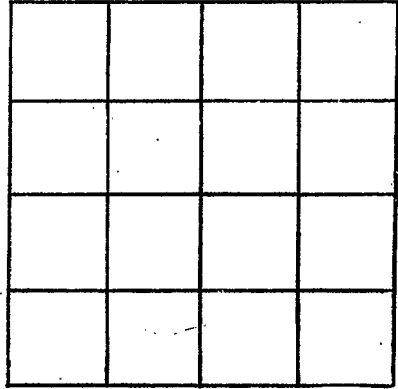

SECTION \_\_\_\_\_

Please indicate well location X.

ADDITIONAL INFORMATION

If more than one screen,  
show locations of each on sketch.