

Union
K-15
7-31-71

MISSISSIPPI
BOARD OF WATER COMMISSIONERS \$17.00
416 North State Street \$750.00
Jackson, Mississippi 39201

913.00
\$17.00
\$750.00

CODED

WATER WELL DRILLERS LOG

7-31-1971 date well completed J.T. Medlin firm name Union county well located

LANDOWNER: P.S. Graham
R# 4. Etta
Miss
(mailing address)

description of formations encountered	from	to
White Clay	0	26
Blue "	26	301
Rock & Clay	301	335
Rock & Sand	335	415

WELL LOCATION:
sec. 3 T 8 N R 1 E
S W
3 miles N W of Pinedale
(distance) (direction) (nearest town)

WELL PURPOSE:
(home, irrigation, municipal, industrial)

- WELL COMPLETION DATA:
- (1) diameter (inches) 4
 - (2) total depth (feet) 415
 - (3) static water level (feet) 35 below top of ground.
 - (4) casing P 95 (material) (depth)
(size) if telescope see back.
 - (5) screen (length) (depth to top)
(size) (material)
 - (6) pump 1 8 (HP) (yield gpm)
E (type power)
 - (7) electric log (yes or no)
(organization running log)
 - (8) how well bottom plugged

CODED


Aug 1 - 1971

DRILLERS REMARKS:

MISS. Bd. of
WATER COMMISSIONERS

If well telescopes please sketch and show depths.

GROUND LEVEL

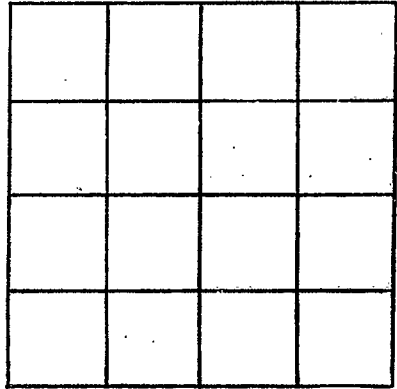

SECTION _____

Please indicate well location X.

ADDITIONAL INFORMATION

If more than one screen,
show locations of each on sketch.