

630.00
 Feb 30 50
 \$ 661.50

UNION
 K 16
 9-1-71

MISSISSIPPI
 BOARD OF WATER COMMISSIONERS
 416 North State Street
 Jackson, Mississippi 39201

WATER WELL DRILLERS LOG

9-1-19 71 date well completed
 J T Madala firm name
 CODED county well located

LANDOWNER:	description of formations encountered	from	to
Will Rutledge Moyette, R# 4 RD	White clay	0	24
	Blue "	24	285
	Rock "	285	320
	Rock & sand	320	360

(mailing address)
 WELL LOCATION:
 sec. 12 T 8 N R 1 E
 S W
 4 miles E of Pinckney
 (distance) (direction) (nearest town)

WELL PURPOSE:
 (home, irrigation, municipal, industrial)

- WELL COMPLETION DATA:
- (1) diameter (inches) 4
 - (2) total depth (feet) 360
 - (3) static water level (feet) 40 below top of ground.
 - (4) casing P 90 (material) (depth)
 (size) If telescope see back.
 - (5) screen 0 (length) (depth to top)
 (size) (material)
 - (6) pump 1 7 (HP) (yield gpm)
 E (type power)
 - (7) electric log (yes or no)
 (organization running log)
 - (8) how well bottom plugged

CODED


OCT 6 1971

MISS. BD. OF WATER COMMISSIONERS

DRILLERS REMARKS:

If well telescopes please sketch and show depths.

GROUND LEVEL

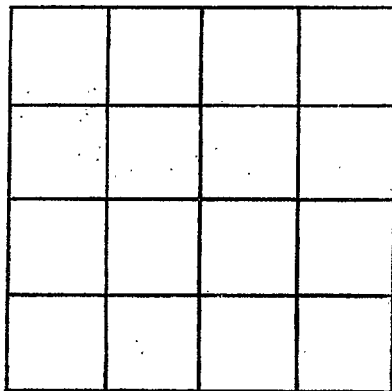

SECTION _____

Please indicate well location X.

ADDITIONAL INFORMATION

If more than one screen, show locations of each on sketch.