

8/1/69

CODED
CODED

Union
K18
7-4-69

MISSISSIPPI
BOARD OF WATER COMMISSIONERS
416 North State Street
Jackson, Mississippi 39201

WATER WELL DRILLERS LOG

17-4-69 19 SAMAR WILDER UNION
date well completed firm name county well located

LANDOWNER: ~~WILDER~~
FULTON KELLY
ETTA MISS
(mailing address)
WELL LOCATION:
sec. 14 T. 8 N. R. 1 E S. 5
12 miles W of ECHO
(distance) (direction) (nearest town)

description of formations encountered	from	to
Red CLAY	0	20
BLACK SHALE	20	80
BLUE SHALE	80	480
Grey SHALE	480	480
ROCK & SAND	480	537

WELL PURPOSE: HOME
(home, irrigation, municipal, industrial)

WELL COMPLETION DATA:
(1) diameter (inches) 4
(2) total depth (feet) 551
(3) static water level (feet) 30 below above of ground.
(4) casing STEEL (material), (depth), (size) if telescope see back.
(5) screen (length) (depth to top) (size) (material)
(6) pump PUMP BY OTHERS (HP) (yield gpm). (type power)
(7) electric log (yes or no) (organization running log)
(8) how well bottom plugged

CODED


JUL 30 1969

MISC. DE. OF
WATER COMM.

DRILLERS REMARKS:

If well telescopes please sketch and show depths.

GROUND LEVEL

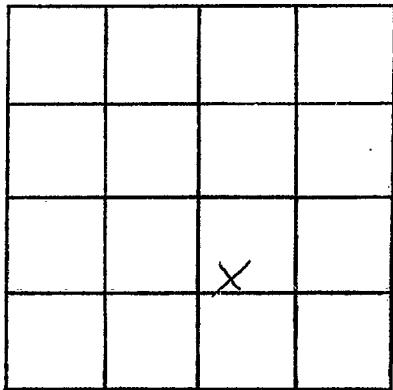

SECTION _____

Please indicate well location X.

ADDITIONAL INFORMATION

Lined area for additional information, consisting of approximately 20 horizontal lines.

If more than one screen, show locations of each on sketch.