

Union
K19
11-29-71

MISSISSIPPI
BOARD OF WATER COMMISSIONERS
416 North State Street
Jackson, Mississippi 39201

745.75
Tel 39 25
\$785.00

WATER WELL DRILLERS LOG **CODED**

11 29 19 71 *J T Madlin* **UNION**
date well completed firm name county well located

LANDOWNER:	description of formations encountered	from	to
<i>Sam Hudson</i>	<i>W. Clay</i>	<i>0</i>	<i>12</i>
<i>Pinedale, Miss</i>	<i>Sand</i>	<i>12</i>	<i>18</i>
(mailing address)	<i>Blue Clay</i>	<i>18</i>	<i>480</i>
WELL LOCATION:	<i>Rock & sand</i>	<i>480</i>	<i>495</i>
sec. <i>9</i> T. <i>8</i> N. <i>SE</i> R. <i>1</i> E	<i>Blue Clay</i>	<i>495</i>	<i>575</i>
<i>1/2</i> miles <i>E</i> of <i>Pinedale</i>			
(distance) (direction) (nearest town)			
WELL PURPOSE:			
(Home, irrigation, municipal, industrial)			
WELL COMPLETION DATA:			
(1) diameter (inches) <i>4</i>			
(2) total depth (feet) <i>575</i>			
(3) static water level (feet) <i>110</i> below top of ground.			
(4) casing <i>P</i> <i>130</i> (material) (depth)			
(size) If telescope see back.			
(5) screen (length) (depth to top)			
(size) (material)			
(6) pump <i>1/2</i> <i>9</i> (HP) (yield gpm)			
(type power) <i>E</i>			
(7) electric log (yes or no)			
(organization running log)			
(8) how well bottom plugged <i>OK</i>			
DRILLERS REMARKS:			


CODED

JAN 5 1972

MISS. BD. OF WATER COMMISSIONERS

If well telescopes please sketch and show depths.

GROUND LEVEL

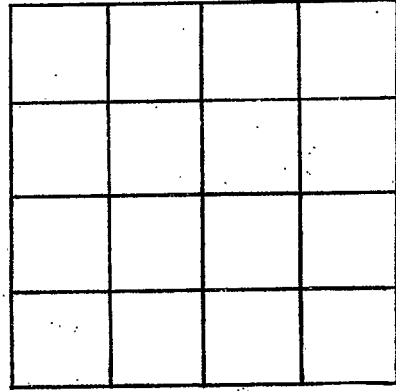

SECTION _____

Please indicate well location X.

ADDITIONAL INFORMATION

If more than one screen,
show locations of each on sketch.