

Union
K20
5-2-72

MISSISSIPPI
BOARD OF WATER COMMISSIONERS
416 North State Street
Jackson, Mississippi 39201

CODED 800.00
45 00
\$ 845 00

WATER WELL DRILLERS LOG

5-28 1972 *J. Meekins* UNION
date well completed firm name county well located

LANDOWNER: *Melvene Blackwood* Pineville
description of formations encountered: *W. Clay, Blue, Rock & sand*
from to: 0 16, 16 310, 310 420
(mailing address)

WELL LOCATION:
sec. 4 T 8 N R 1 E
1 miles NW of Pineville
(distance) (direction) (nearest town)

WELL PURPOSE:
(home, irrigation, municipal, industrial)

- WELL COMPLETION DATA:
- (1) diameter (inches) 4
 - (2) total depth (feet) 720
 - (3) static water level (feet) 63 below top of ground.
 - (4) casing P 80
(material) (depth)
(size) if telescope see back.
 - (5) screen _____
(length) (depth to top)
(size) (material)
 - (6) pump 3/4 5
(HP) (yield gpm)
E
(type power)
 - (7) electric log _____
(yes or no)
(organization running log)
 - (8) how well bottom plugged _____

CODED


JUN - 6 1972

MISS. BD. OF
WATER COMM.

DRILLERS REMARKS:

If well telescopes please sketch and show depths.

GROUND LEVEL

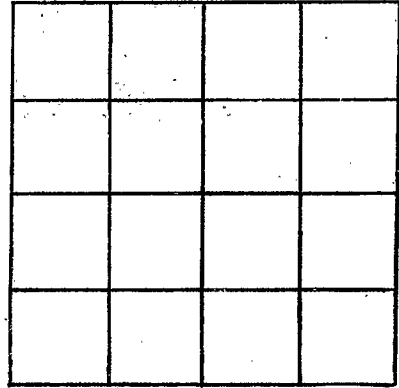

SECTION _____

Please indicate well location X.

ADDITIONAL INFORMATION

If more than one screen,
show locations of each on sketch.