

Union  
K22  
9-1-72

MISSISSIPPI  
 BOARD OF WATER COMMISSIONERS  
 416 North State Street  
 Jackson, Mississippi 39201

**CODED**

WATER WELL DRILLERS LOG

Sept 1 1972 J. W. Welbourn Union  
 date well completed firm name county well located

LANDOWNER: Jane Hale  
Ecum miss  
 (mailing address)

WELL LOCATION:  
 sec. 13 T. 95 N R. 1 E  
 S W  
5 miles west of Ecum  
 (distance) (direction) (nearest town)

WELL PURPOSE:  
 (home, irrigation, municipal, industrial)

- WELL COMPLETION DATA:
- (1) diameter (inches) 5"
  - (2) total depth (feet) 340ft
  - (3) static water level (feet) 60 below above top of ground.
  - (4) casing Steel, 6.3ft  
 (material) (depth)  
5"  
 (size) if telescope see back.
  - (5) screen 0 0  
 (length) (depth to top)  
0 0  
 (size) (material)
  - (6) pump 1-hp jet 8  
 (HP) (yield gpm)  
Elec  
 (type power)
  - (7) electric log no  
 (yes or no)
- (organization running log)
- (8) how well bottom plugged open

description of formations encountered	from	to
Soil	0	1
Humo	1	55
Blue Rock	55	245
Water Rock	245	247
Water sand + Rocks	247	340
Ripley Sand		

**CODED**


NOV 15 1972

WATER

DRILLERS REMARKS:

If well telescopes please sketch and show depths.

GROUND LEVEL

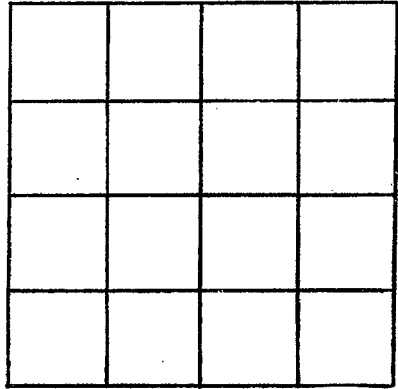

SECTION \_\_\_\_\_

Please indicate well location X.

ADDITIONAL INFORMATION

A series of horizontal lines for recording additional information.

If more than one screen, show locations of each on sketch.