

CODED
100.00
45.00
945.00

UNION
K24
6-23-73

MISSISSIPPI
BOARD OF WATER COMMISSIONERS
416 North State Street
Jackson, Mississippi 39201

WATER WELL DRILLERS LOG

10 23 1973
date well completed

JT Hedlin
firm name

UNION
county well located

LANDOWNER:
C.H. Thomas
C.H. Thomas
(mailing address)

description of formations encountered	from	to
Clay	0	18
blue clay	18	370
rock & sand	370	475

WELL LOCATION:
sec. 10 T 8 N R 1 E
1 miles S of Pinebluff
(distance) (direction) (nearest town)

WELL PURPOSE:
(home, irrigation, municipal, industrial)

WELL COMPLETION DATA:

- (1) diameter (inches) 4
- (2) total depth (feet) 475
- (3) static water level (feet) 90 below top of ground.
- (4) casing (material) P (depth) 100
- (size) If telescope see back.
- (5) screen (length) (depth to top)
- (size) (material)
- (6) pump (HP) 2 (yield gpm) 7
- (type power) E
- (7) electric log (yes or no)
- (organization running log)
- (8) how well bottom plugged


CODED

JUL 23 1973

DRILLERS REMARKS:

If well telescopes please sketch and show depths.

GROUND LEVEL

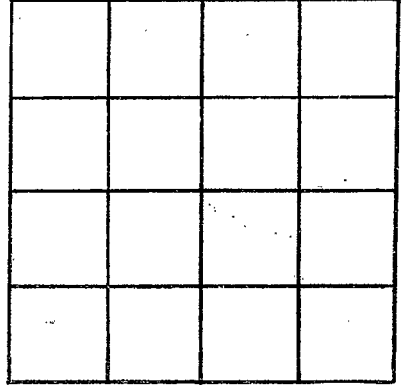

SECTION _____

Please indicate well location X.

ADDITIONAL INFORMATION

If more than one screen, show locations of each on sketch.