

Union
K 27
6-18-75

MISSISSIPPI
BOARD OF WATER COMMISSIONERS
416 North State Street
Jackson, Mississippi 39201

1,260-00
CODED 300

WATER WELL DRILLERS LOG

6-18-1975 date well completed
J T Medlin firm name
Union county well located

LANDOWNER: Joe Mayhew
Pineblake
(mailing address)
WELL LOCATION:
sec. 2 T 8 N R 1 E 15F
2 miles E of P.D.
(distance) (direction) (nearest town)

description of formations encountered	from	to
Clay	0	18
Clay	18	26
Sand	26	42.0
Clay	42.0	510
Dark sand		

WELL PURPOSE:
(home, irrigation, municipal, industrial)


WELL COMPLETION DATA:
(1) diameter (inches) 4
(2) total depth (feet) 510
(3) static water level (feet) 86 below top of ground
(4) casing P 160 (material) (depth)
(size) if telescope see back.
(5) screen (length) (depth to top)
(size) (material)
(6) pump 3/4 10 (HP) (yield gpm)
(type power) E
(7) electric log (yes or no)
(organization running log)
(8) how well bottom plugged

DRILLERS REMARKS:

RECEIVED
JUL - 9 1975

If well telescopes please sketch and show depths.

GROUND LEVEL

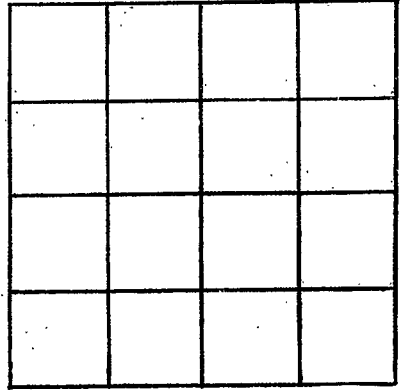

SECTION _____

Please indicate well location X.

ADDITIONAL INFORMATION

If more than one screen, show locations of each on sketch.