

Union
K 28
6-16-75

MISSISSIPPI
BOARD OF WATER COMMISSIONERS
416 North State Street
Jackson, Mississippi 39201

[Signature]

WATER WELL DRILLERS LOG

CODED

6-16-1975 date well completed 25 J T Medina firm name Union county well located


LANDOWNER: <i>Church of Lord Jesus Christ Pinedale</i> (mailing address)	description of formations encountered	from	to
	Clay	0	19
	Sand	18	26
	Clay	26	360
	rock & sand	360	420
WELL LOCATION:			
sec. 10 T 8 N R 1 E 15F			
1 miles E of Pinedale			
(distance) (direction) (nearest town)			
WELL PURPOSE: (home, irrigation, municipal, industrial)			
WELL COMPLETION DATA:			
(1) diameter (inches) <u>4</u>			
(2) total depth (feet) <u>420</u>			
(3) static water level (feet) <u>110</u> below above top of ground.			
(4) casing <u>P</u> <u>160</u> (material) (depth)			
_____ If telescope see back. (size)			
(5) screen _____ (length) (depth to top)			
_____ (size) _____ (material)			
(6) pump <u>1/2</u> <u>6</u> (HP) (yield gpm)			
<u>e</u> (type power)			
(7) electric log _____ (yes or no)			
_____ (organization running log)			
(8) how well bottom plugged _____			
DRILLERS REMARKS:			

RECEIVED
JUL - 9 1975

MISS. BD. OF WATER COMMISSIONERS

If well telescopes please sketch and show depths.

GROUND LEVEL

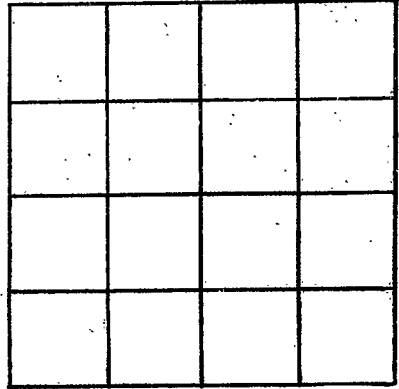

SECTION _____

Please indicate well location X.

ADDITIONAL INFORMATION

If more than one screen, show locations of each on sketch.