

# State Well Report

## Part 1

Mississippi Department of Environmental Quality  
Office of Land and Water Resources  
P.O. Box 10631  
Jackson, MS 39289-0631  
(601)961-5210  
(601)354-6938 (fax)

County: Union  
Permit #: \_\_\_\_\_  
Driller: Leeper Drilling  
Date drilling completed: 9-21-05

For Office Use Only:  
Aquifer: \_\_\_\_\_  
Well #: K-32  
L. S. Elevation: \_\_\_\_\_  
E-log #: \_\_\_\_\_

State Law requires that this report be prepared by the driller in detail and filed with the Department within 30 days of completion of drilling of the well.

Well Owner Information	Well Location
Owner Name: <u>Dustin Ponder</u>	Latitude: _____ Longitude: _____
Mailing Address: <u>P.O. Box 152</u>	Method of Lat/Long (circle one): Conventional Survey, USGS quad, Hand-held GPS, Survey-grade GPS
<u>New Albany MS 38652</u>	<u>1/4 1/4 Sec 3 Twn 8 S Rng 1 E</u>
City State Zip Code	Distance Direction Nearest Town
Telephone No. <u>(662) 534-8046</u>	<u>11 Miles SW of New Albany</u>

**Well Data**

Purpose of Well (circle one) Home 7 Industrial Public Supply Irrigation Fish Culture Other: \_\_\_\_\_

Date well drilling started: 9-19-05 Date well drilling completed: 9-21-05

If flowing, method of flow regulation: Valve \_\_\_\_\_ Other (describe) \_\_\_\_\_

Static Water Level: 60 feet above or below (circle one) land surface Date measured: 9-22-05

Method of Measurement (circle one) steel tape electric tape air line other: \_\_\_\_\_

Hole depth: 415' Well depth: 415' Well grouted to a depth of 10 feet

Type of grout (circle one): Cement Bentonite Mix

Casing length: 240 feet Casing diameter: 4" inches Type of casing: PVC

Screen length: 40 feet Screen diameter: 2" inches Type of screen: PVC

Screen slot size: .010 inches Setting depth: From 375 feet to 415 feet

Type of completion (circle all applicable): Gravel packed Underreamed Telescoped Open hole Natural Development  
Other (describe): \_\_\_\_\_

Top of lap pipe or reduction in casing: \_\_\_\_\_ feet. If telescoped or more than one screen, describe on back of page

Logs run (circle all applicable): No log run Electric Gamma Ray Density Sonic Neutron Other: \_\_\_\_\_

Name of organization running log(s): \_\_\_\_\_

I certify that the well was drilled, constructed, and completed in accordance with all applicable requirements of the Mississippi Department of Environmental Quality and/or the Mississippi Department of Health regulations and state laws.


LEEPER Drilling #0079  
Print Name of Water Well Contractor and License No.

[Signature]  
Signature of Water Well Contractor

RECEIVED  
OCT 17 2005  
BY: OLWF

If well telescopes please sketch below and show depths.


K-32

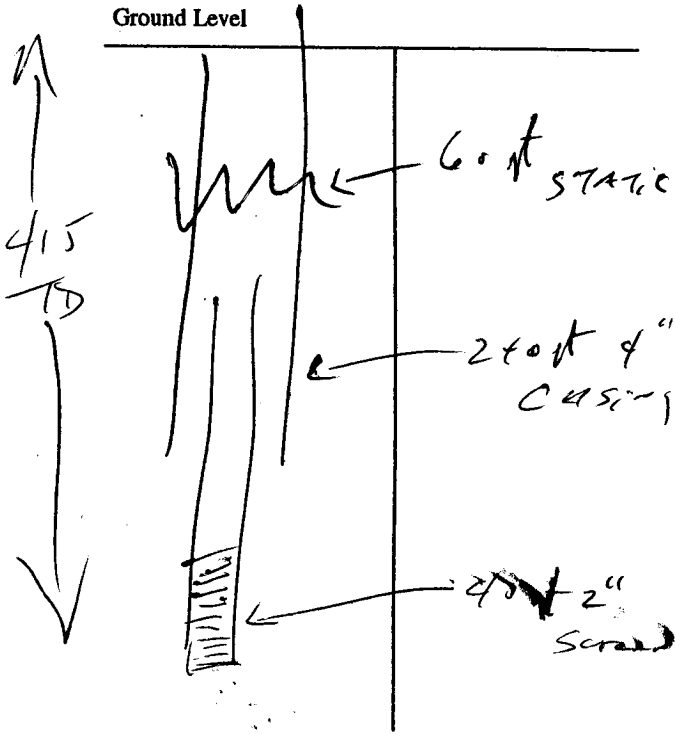

Description of Formations Encountered	From	To
TOP CLAY	0	20
Blue clay	20	220
CHALK	220	375
SAND	375	415

If more than one screen, show location of each on sketch

Sketch the property layout and include the following: 1) the well location; 2) any permanent structures on the property that may aid in locating the well; 3) any roads, power lines, or other items that may aid in locating the property and the well; 4) indicate direction.

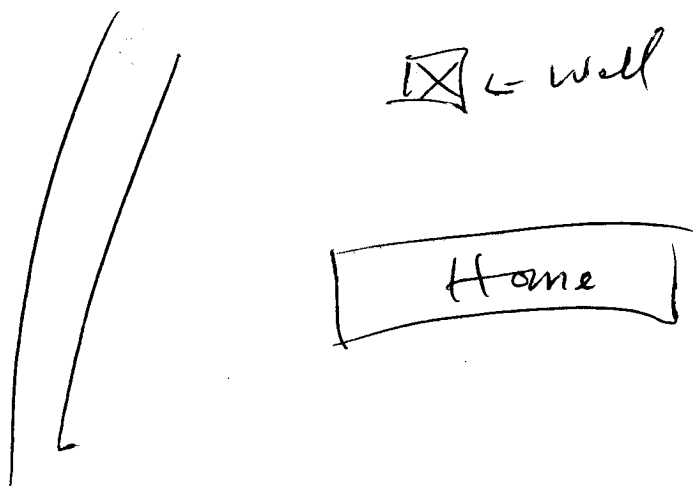

Landowner Name: Dustin Powder

[Signature]  
Signature of Water Well Contractor

RECEIVED  
OCT 17 2005  
BY: OLWR

# STATE WELL REPORT

## Part 2

**Pump Installer's Completion Report**  
 Mississippi Department of Environmental Quality  
 Office of Land and Water Resources  
 P.O. Box 10631  
 Jackson, MS 39289-0631  
 (601)961-5210  
 (601)354-6938 (fax)

For Office Use Only:

Aquifer: \_\_\_\_\_

Well #: K-32

Elevation: \_\_\_\_\_

County: Union  
 Permit #: \_\_\_\_\_  
 Driller: Leeper Drilling  
 Date completed: 9-22-05

**This report should be prepared by the pump installer in detail and filed with the Department within 30 days of the installation of pump.**

Well Owner Information	Well Location
Owner Name: <u>Dustin Founders</u>	Latitude: _____ Longitude: _____
Mailing Address: <u>P.O. Box 192</u>	Method of Lat/Long (circle one): Conventional Survey, USGS quad, Hand-held GPS, Survey-grade GPS
<u>New Albany MS 38652</u>	_____ 1/4 _____ 1/4 Sec <u>3</u> Twn <u>8 S</u> Rng <u>1 E</u>
City State Zip Code	Distance Direction Nearest Town
Telephone No. <u>(662) 534-8046</u>	<u>11</u> Miles <u>SW</u> of <u>New Albany</u>

Pump Type Circle one	Power Type Circle one
Air Lift Jet <input type="radio"/> <b>Submersible</b> <input checked="" type="radio"/>	Diesel Engine Gasoline Engine Natural Gas
Bucket Piston <input type="radio"/> Turbine <input type="radio"/>	<b>Electric Motor</b> <input checked="" type="radio"/> Hand <input type="radio"/> Tractor PTO <input type="radio"/>
Centrifugal Rotary <input type="radio"/> Flowing Well <input type="radio"/>	Windmill Other (specify): _____
Other (specify): _____	Horse Power Rating of Motor: <u>3/4 HP</u>
Date Pump Installed: <u>9-22-05</u>	Setting Depth: <u>100</u> feet
Rated Pump Capacity: <u>10</u> Gallons Per Minute	Number of Stages: <u>11</u>

Pump Test Data	Method of Measuring Water Level Circle one
Date Well Tested: <u>9-22-05</u>	Air Line Electric Measuring Line <b>Steel Tape</b> <input checked="" type="radio"/>
Static Water Level (A): <u>60</u> Feet <b>Below</b> Land Surface	Other (specify): _____
Pumping Water Level (B): _____ Feet Below Land Surface	For flowing well, measured shut in head: _____ feet
Drawdown [(B) - (A)]: _____ Feet Below Land Surface	Well yielded _____ GPM with a drawdown of _____ feet after _____ hours of pumping
Test Pumping Rate: _____ Gallons Per Minute	
Duration of Pump Test (minimum 4 hours): _____ hours	

I HEREBY CERTIFY that the above statements are true to the best of my knowledge.

LEPER Drilling #0079  
 Print Name of Pump Installer and License No. (if applicable)

[Signature]  
 Signature of Pump Installer

**RECEIVED**  
 OCT 17 2005  
 BY: OLWR