

**MISSISSIPPI
BOARD OF WATER COMMISSIONERS**
416 North State Street
15F Jackson, Mississippi 39201

WATER WELL DRILLERS LOG

Union
K 2000
9-15-77

~~Sept 15, 1977~~ Sept 15, 1977 J. W. Webb & Son Union
date well completed firm name county well located

LANDOWNER: W. H. Hudson
Etta, miss
(mailing address)

WELL LOCATION:
sec. 6 T 8S N R 1 E
S W
4 1/2 miles South of Etta
(distance) (direction) (nearest town)

WELL PURPOSE:
(home, irrigation, municipal, industrial)

- WELL COMPLETION DATA:
- (1) diameter (inches) 4"
 - (2) total depth (feet) 700
 - (3) static water level (feet) 144 below above top of ground.
 - (4) casing steel, 336'
(material) (depth)
 If telescope see back.
(size)
 - (5) screen 0 0
(length) (depth to top)
 (size) (material)
 - (6) pump 1 1/2 HP Rod 3
(HP) (yield gpm)
Elec
(type power)
 - (7) electric log
(yes or no)
 (organization running log)
 - (8) how well bottom plugged


description of formations encountered	from	to
Soil	0	1
Sumko	1	30
Sand & Clay	30	130
Pink Clay	130	150
Sand & Clay	150	250
Blue Rock	250	560
Water Rock	560	566
Water Sand & Rock	566	400
Replay Sand		

DRILLERS REMARKS:

RECEIVED
OCT 12 1977

If well telescopes please sketch and show depths.

GROUND LEVEL

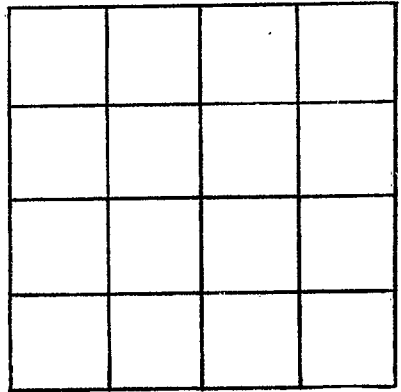

SECTION _____

Please indicate well location X.

ADDITIONAL INFORMATION

If more than one screen, show locations of each on sketch.