

UNION

K 2000

10-6-77

MISSISSIPPI
BOARD OF WATER COMMISSIONERS
416 North State Street
15F Jackson, Mississippi 39201

WATER WELL DRILLERS LOG

10-6
date well completed

1977 BRYANTS WELL DRILLING UNION
firm name county well located

LANDOWNER:

LOWELL ROBBINS

PINEDALE MS.
(mailing address)

description of formations encountered

from to

Clay 0 40
Blue Clay 110 250
SAND + ROCK 350 410

WELL LOCATION:

sec. 1 T. 8 N. R. 10 E
2 miles South of Pinedale
(distance) (direction) (nearest town)

WELL PURPOSE: HOME
(home, irrigation, municipal, industrial)

WELL COMPLETION DATA:

(1) diameter (inches) 4 1/2
(2) total depth (feet) 410
(3) static water level (feet) 70 below top of ground

(4) casing P.I.A.S. 115
(material) (depth)

(size) If telescope see back.

(5) screen (length) (depth to top)

(size) (material)

(6) pump 1 Jet 8
(HP) (yield gpm)

(type power)

(7) electric log (yes or no)

(organization running log)

(8) how well bottom plugged OPEN


DRILLERS REMARKS:

RECEIVED
NOV 21 1977

MISS. BO. OF WATER COMMISSIONERS

If well telescopes please sketch and show depths.

GROUND LEVEL

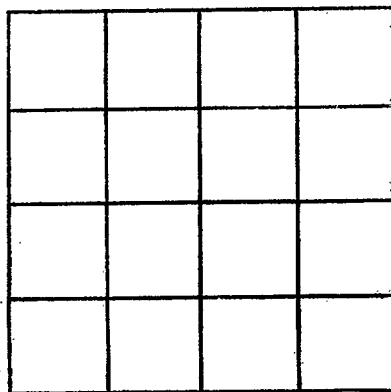

SECTION _____

Please indicate well location X.

ADDITIONAL INFORMATION

If more than one screen, show locations of each on sketch.