

UNION
K 2002
2-3-78

**MISSISSIPPI
BOARD OF WATER COMMISSIONERS**
416 North State Street
Jackson, Mississippi 39201

WATER WELL DRILLERS LOG

2-3 1978 *Leaper* *Union*
 date well completed firm name county well located

LANDOWNER:
L.C. Wallace
Rt. 1 Etta, Ms.
 (mailing address)

description of formations encountered	from	to
<i>Jointed clay</i>	<i>0</i>	<i>20'</i>
<i>Blue clay</i>	<i>20</i>	<i>100'</i>
<i>Chalk</i>	<i>200'</i>	<i>520'</i>
<i>Sand</i>	<i>520'</i>	<i>621'</i>

WELL LOCATION:
 sec. *17* T. *8* N. R. *1* E
 (3)? miles *S* of *Etta*
 (distance) (direction) (nearest town)

WELL PURPOSE:
 (home, irrigation, municipal, industrial)

WELL COMPLETION DATA:

(1) diameter (inches) *4*

(2) total depth (feet) *621*

(3) static water level (feet) _____ below/above top of ground.

(4) casing *Steel* *126'*
 (material) (depth)
 _____ if telescope see back.
 (size)

(5) screen _____ (length) _____ (depth to top)
 (size) (material):


(6) pump *3/4 hpd* *3*
 (HP) (yield gpm)
Elec.
 (type power)

(7) electric log *no*
 (yes or no)

 (organization running log)

(8) how well bottom plugged *open*


DRILLERS REMARKS:

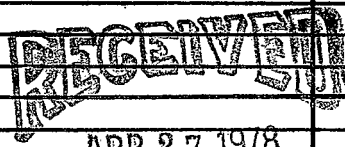

APR 27 1978

If well telescopes please sketch and show depths.

GROUND LEVEL

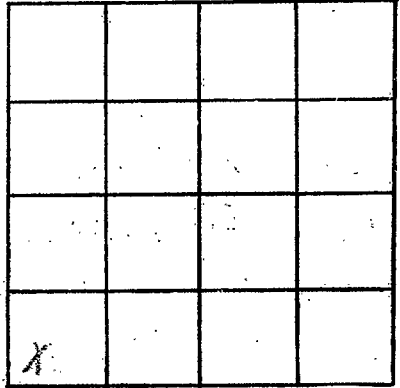

SECTION 17

Please indicate well location X.

ADDITIONAL INFORMATION

If more than one screen, show locations of each on sketch.