

UNION
K 2003

**MISSISSIPPI
BOARD OF WATER COMMISSIONERS**
416 North State Street
Jackson, Mississippi 39201

WATER WELL DRILLERS LOG

3-19-78 19 Bryants Well Drilling Union
 date well completed firm name county well located

LANDOWNER:	description of formations encountered	from	to
<u>Jerry Beavers</u>			
<u>Elton Miss</u> (mailing address)	<u>Mixed Clay</u>	<u>0</u>	<u>3.5</u>
	<u>Blue Clay</u>	<u>35</u>	<u>400</u>
	<u>Sand & Rock</u>	<u>400</u>	<u>480</u>

WELL LOCATION:
 sec. 1 T 8 N R 1 E
13 miles West of New Albany
 (distance) (direction) (nearest town)

WELL PURPOSE: None
 (home, irrigation, municipal, industrial)

WELL COMPLETION DATA:

(1) diameter (inches) 4"

(2) total depth (feet) 480

(3) static water level (feet) 60 below above top of ground.

(4) casing Plos 130
 (material) (depth)
 (size) if telescope see back.

(5) screen _____ (length) _____ (depth to top)
 (size) 1/2 (material) _____

(6) pump 2 11
 (HP) (yield gpm)
Electric
 (type power)

(7) electric log _____ (yes or no)
 _____ (organization running log)

(8) how well bottom plugged Open

RECEIVED


AUG - 3 1978

DRILLERS REMARKS: _____

MISS. BD. OF WATER COMM.

If well telescopes please sketch and show depths.

GROUND LEVEL

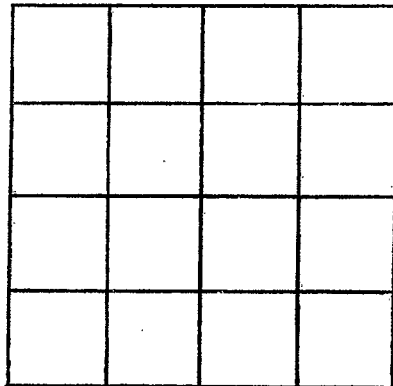

SECTION _____

Please indicate well location X.

ADDITIONAL INFORMATION

If more than one screen,
show locations of each on sketch.