

Union
 R 2004
 11-28-78

MISSISSIPPI
 BOARD OF WATER COMMISSIONERS
 416 North State Street
 Jackson, Mississippi 39201

WATER WELL DRILLERS LOG

11-28 1978 Leaper Union
 date well completed firm name county well located

LANDOWNER:	description of formations encountered	from	to
Richard Willard Rt. 1 New Albany (mailing address)			
	Blue clay	20	400
	White sand	400	470

WELL LOCATION:
 sec. 9 T. 8 N. R. 1 E
Pinedale Comm.
 miles of (distance) (direction) (nearest town)

WELL PURPOSE: None
 (home, irrigation, municipal, industrial)

WELL COMPLETION DATA:

- (1) diameter (inches) 4"
- (2) total depth (feet) 470'
- (3) static water level (feet) 60 ^{below} above top of ground.
- (4) casing PVC, 100,
 (material) (depth)
 (size) If telescope see back.
- (5) screen _____
 (length) (depth to top)
X, XXXX
 (size) (material)
- (6) pump 1HP 8
 (HP) (yield gpm)
Elec
 (type power)
- (7) electric log no
 (yes or no)
 (organization running log)
- (8) how well bottom plugged open
bottom

Miss. Board of Water Comm.


JUN - 4 1979

RECEIVED

DRILLERS REMARKS:

If well telescopes please sketch and show depths.

GROUND LEVEL

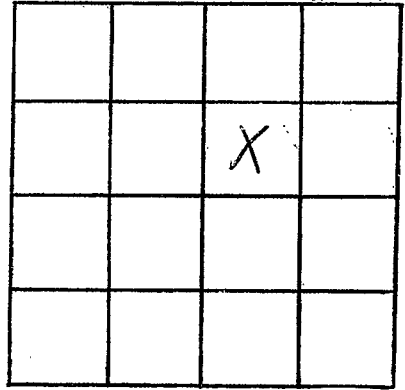

SECTION 9

Please indicate well location X.

ADDITIONAL INFORMATION

If more than one screen,
show locations of each on sketch.