

UNION
K 2005
12-29-78

MISSISSIPPI
 BOARD OF WATER COMMISSIONERS
 416 North State Street
 Jackson, Mississippi 39201

WATER WELL DRILLERS LOG

12-29 1978 Leaper Union
 date well completed firm name county well located

LANDOWNER:	description of formations encountered	from	to
<u>Larry Roberts</u> <u>Rt 1 Otta, Mo.</u> (mailing address)			

WELL LOCATION:
 sec. 9 T 8 N R 1 E
Binedale Community
 miles of of
 (distance) (direction) (nearest town)

WELL PURPOSE: Home
 (home, irrigation, municipal, industrial)

- WELL COMPLETION DATA:
- (1) diameter (inches) 4"
 - (2) total depth (feet) 465'
 - (3) static water level (feet) 60 ^{below} above top of ground.
 - (4) casing PVC 100
 (material) (depth)
 _____ if telescope see back.
 (size)
 - (5) screen _____
 (length) (depth to top)

 (size) (material)
 - (6) pump 1 HP 8
 (HP) (yield gpm)
Edco
 (type power)
 - (7) electric log No
 (yes or no)

 (organization running log)
 - (8) how well bottom plugged open
bottom

Miss. Board of Water Comm.


JUN 4 1979

DRILLERS REMARKS:

RECEIVED

If well telescopes please sketch and show depths.

GROUND LEVEL

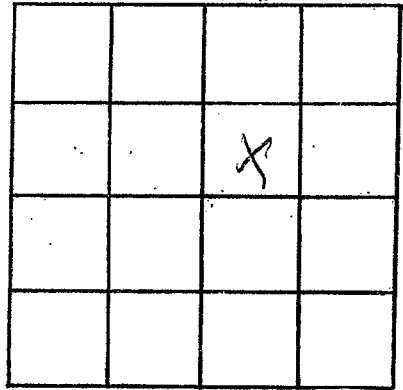

SECTION 9

Please indicate well location X.

ADDITIONAL INFORMATION

If more than one screen,
show locations of each on sketch.