

Union  
K. J. J. J.  
9/12/79  
9 12

MISSISSIPPI  
BOARD OF WATER COMMISSIONERS  
416 North State Street  
Jackson, Mississippi 39201

WATER WELL DRILLERS LOG

1979 J. T. Medlin UNION  
date well completed firm name county well located

LANDOWNER:	description of formations encountered	from	to
Savern Ketchum	Clay	0	280
HW 30 West New Albany (mailing address)	Rock & Sand	280	390

WELL LOCATION:  
sec. 19 T 2 N R 12 E  
1 miles S of Poolsville  
(distance) (direction) (nearest town)

WELL PURPOSE:  
(home, irrigation, municipal, industrial)


- WELL COMPLETION DATA:
- (1) diameter (inches) 4
  - (2) total depth (feet) 390
  - (3) static water level (feet) 60 below top of ground.
  - (4) casing P 120 (material) (depth)  
(size) if telescope see back.
  - (5) screen (length) (depth to top)  
(size) (material)
  - (6) pump 2 10 (HP) (yield gpm)  
E (type power)
  - (7) electric log (yes or no)  
(organization running log)
  - (8) how well bottom plugged apr

DRILLERS REMARKS:

10' 11' 12' 13' 14' 15' 16' 17' 18' 19' 20' 21' 22' 23' 24' 25' 26' 27' 28' 29' 30' 31' 32' 33' 34' 35' 36' 37' 38' 39' 40'

If well telescopes please sketch and show depths.

GROUND LEVEL

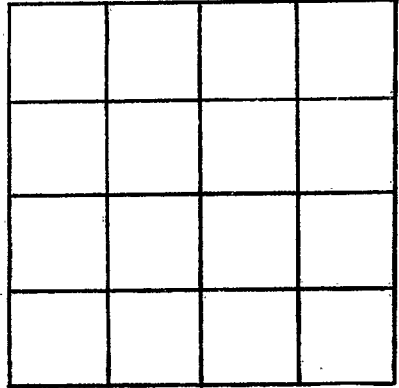

SECTION \_\_\_\_\_

Please indicate well location X.

ADDITIONAL INFORMATION

If more than one screen,  
show locations of each on sketch.