

Union  
K 2009  
5-29-81

MISSISSIPPI  
BOARD OF WATER COMMISSIONERS  
416 North State Street  
Jackson, Mississippi 39201

WATER WELL DRILLERS LOG


5-29-81 date well completed      J.T. Madlin firm name      UNION county well located

LANDOWNER:	description of formations encountered	from	to
Mike Whiseman Rt 1 Box 386 27 (mailing address)	SAND & Rock & Blue clay	0	180
WELL LOCATION: sec 2 T 8 N R 1 E 2 mi miles E of Pinedale (distance) (direction) (nearest town)	Blue clay	180	280
WELL PURPOSE: (home, irrigation, municipal, industrial)	Blue clay	280	480
WELL COMPLETION DATA:	& Rock		
(1) diameter (inches) 4	SAND & Shell	480	530
(2) total depth (feet) 500			
(3) static water level (feet) 30 below top of ground			
(4) casing PVC 2 3/4" (material) (depth) 4 If telescope see back. (size)			
(5) screen (length) (depth to top)			
(size) (material)			
(6) pump 1/2 13 (HP) (yield gpm)			
Etc (type power)			
(7) electric log (yes or no)			
(organization running log)			
(8) how well bottom plugged			
DRILLERS REMARKS:			



If well telescopes please sketch and show depths.

GROUND LEVEL

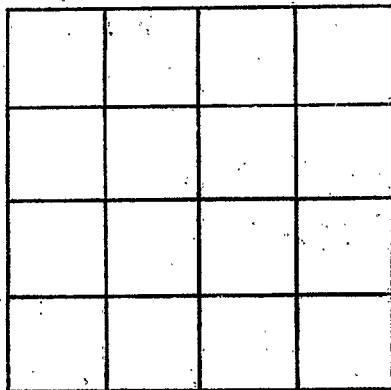

SECTION \_\_\_\_\_

Please indicate well location X.

ADDITIONAL INFORMATION

If more than one screen, show locations of each on sketch.