

MISSISSIPPI DEPARTMENT OF NATURAL RESOURCES

Bureau of Land and Water Resources

Southport Mall

P.O. Box 10631

Jackson, Mississippi 39209

WATER WELL DRILLERS LOG

Union
K 2012

9-12-83
date well completed

1983 Melvin
firm name

Union
county well located

LANDOWNER:
Leo Wallace
Pineland
(mailing address)

description of formations encountered	from	to
<u>sand</u>	<u>0</u>	<u>190</u>
<u>Clay & sand</u>	<u>190</u>	<u>330</u>
<u>Clay - Rock</u>	<u>330</u>	<u>520</u>
<u>Discontinuity of aquifer</u>	<u>520</u>	<u>61</u>

WELL LOCATION:
sec 8 T N R 1 E
S miles W of Pineland
(distance) (direction) (nearest town)

WELL PURPOSE:
(home, irrigation, municipal, industrial)

WELL COMPLETION DATA

- (1) diameter (inches) 4
- (2) total depth (feet) 680
- (3) static water level (feet) 300 below top of ground
- (4) casing Pvc 490
(material) (depth)
- (size) If telescope see back.
- (5) screen (length) (depth to top)
(size) (material)
- (6) pump 1 10
(HP) (yield gpm)
- (type power)
- (7) electric log (yes or no)
(organization running log)
- (8) how well bottom plugged


DRILLERS REMARKS:

DEPT. OF NATURAL RESOURCES
BUREAU OF LAND & WATER RESOURCES

OCT 20 1983
RECEIVED

If well telescopes please sketch and show depths.

GROUND LEVEL

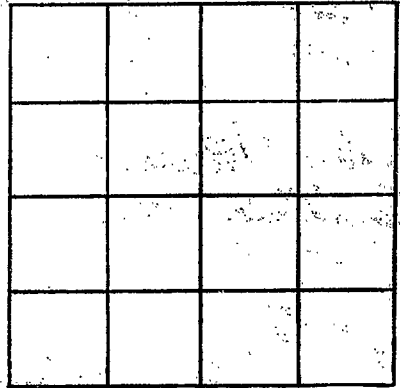

SECTION _____

Please indicate well location X.

ADDITIONAL INFORMATION

If more than one screen, show locations of each on sketch.