

MISSISSIPPI DEPARTMENT OF NATURAL RESOURCES

Bureau of Land and Water Resources

Southport Mall

P.O. Box 10631

Jackson, Mississippi 39209

WATER WELL DRILLERS LOG

UNION
K 2017

MARCH 1986
date well completed

LEEPER Drilling
firm name

Union
county well located

LANDOWNER: K.M. Thomas
Blue Mt. Ms.
(mailing address)


description of formations encountered	from	to
TOP CLAY	0	20
Blue clay	20	260
CHALK	260	400
White Sand	400	460

WELL LOCATION:
sec. 10 T-8 N-1 R-1 E
15 miles S.W. of NEW ALBANY
(distance) (direction) (nearest town)

WELL PURPOSE: Home
(home, irrigation, municipal, industrial)

- WELL COMPLETION DATA:
- (1) diameter (inches) 4"
 - (2) total depth (feet) 460'
 - (3) static water level (feet) 100' below above top of ground.
 - (4) casing PVC 200'
(material) (depth)
4" if telescope see back.
(size)
 - (5) screen NONE
(length) (depth to top)
(size) (material)
 - (6) pump 3/4 10
(HP) (yield gpm)
ELEC
(type power)
 - (7) electric log NO
(yes or no)
(organization running log)
 - (8) how well bottom plugged OPEN


DRILLERS REMARKS:

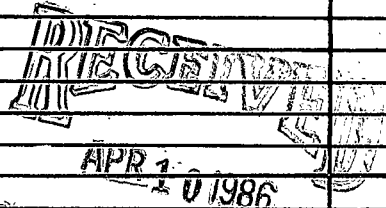

Department of Natural Resources
Bureau of Land & Water Resources

If well telescopes please sketch and show depths.

GROUND LEVEL

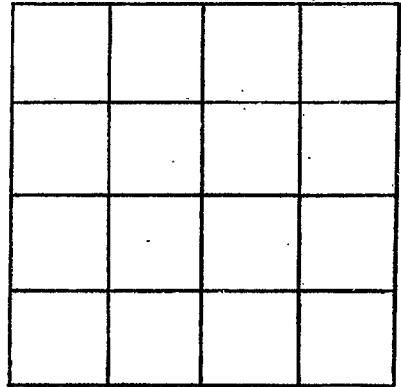

SECTION _____

Please indicate well location X.

ADDITIONAL INFORMATION

If more than one screen, show locations of each on sketch.