

Union
K 2018

MISSISSIPPI
BOARD OF WATER COMMISSIONERS
416 North State Street
Jackson, Mississippi 39201

WATER WELL DRILLERS LOG

July 1986 date well completed
Keeper Drilling firm name
Union county well located

LANDOWNER: CHARLES Collier
Rt 1 ETTA
(Pinedale Community)
(mailing address)

WELL LOCATION:
sec. 11 T 8 N R 1 E
15 miles SW of New Albany
(distance) (direction) (nearest town)

WELL PURPOSE:
(home, irrigation, municipal, industrial)

- WELL COMPLETION DATA:
- (1) diameter (inches) 4"
 - (2) total depth (feet) 502
 - (3) static water level (feet) 90 ^{below}/_{above} top of ground.
 - (4) casing PVC, 200'
(material) (depth)
4"
(size) If telescope see back.
 - (5) screen _____
(length) (depth to top)
(size) (material)
 - (6) pump 1 11
(HP) (yield gpm)
elec
(type power)
 - (7) electric log N/A
(yes or no)
(organization running log)
 - (8) how well bottom plugged OPEN

description of formations encountered	from	to
TOP CLAY	0	20
Blue clay	20	180
CHALK	180	460
SAND	460	502

RECEIVED


AUG 5 1986

Department of Natural Resources
Mississippi Water Resources

DRILLERS REMARKS:

If well telescopes please
sketch and show depths.

GROUND LEVEL

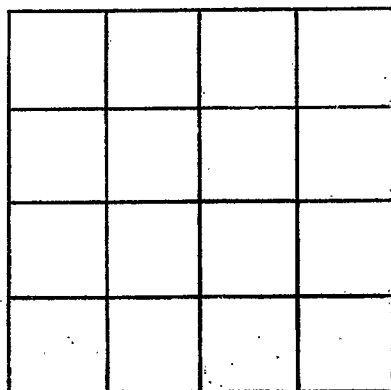

SECTION _____

Please indicate well location X.

ADDITIONAL INFORMATION

If more than one screen,
show locations of each on sketch.