

UNION
K 2018

MISSISSIPPI
BOARD OF WATER COMMISSIONERS
416 North State Street
Jackson, Mississippi 39201

WATER WELL DRILLERS LOG

April 19 86 Leeper Drilling Union
date well completed firm name county well located

LANDOWNER: C. J. COOPER

description of formations encountered

from to

Rt 1 ETTA, MS
(Pinedale Community)
(mailing address)

Top clay	0	20
Blue clay	20	110
CHALK	110	350
SAND	350	430

WELL LOCATION:


sec. 4 T 8 N R 1 E
S W

miles of
(distance) (direction) (nearest town)

WELL PURPOSE: HOME
(home, irrigation, municipal, industrial)

WELL COMPLETION DATA:

- (1) diameter (inches) 4"
- (2) total depth (feet) 430
- (3) static water level (feet) 90 ^{below} _{above} top of ground.
- (4) casing PVC, 200',
(material) (depth)
4" If telescope see back.
(size)
- (5) screen _____
(length) (depth to top)
(size) (material)
- (6) pump 3/4 10
(HP) (yield gpm)
ELEC
(type power)
- (7) electric log NO
(yes or no)
(organization running log)
- (8) how well bottom plugged OPEN

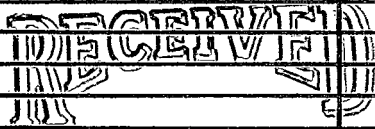


AUG 5 1986

Department of Natural Resources
BUREAU OF LAND & WATER RESOURCES

DRILLERS REMARKS:

If well telescopes please sketch and show depths.

GROUND LEVEL

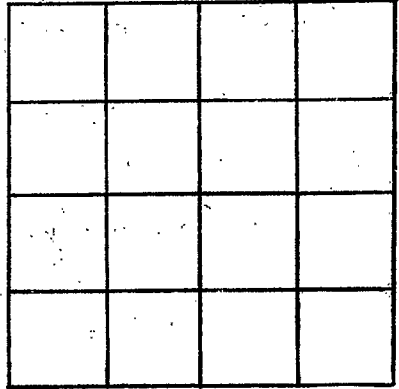

SECTION _____

Please indicate well location X.

ADDITIONAL INFORMATION

If more than one screen,
show locations of each on sketch.