

UNION  
K 2021

MISSISSIPPI  
BOARD OF WATER COMMISSIONERS  
416 North State Street  
Jackson, Mississippi 39201

WATER WELL DRILLERS LOG

Aug 1986 Leeper Drilling Union  
date well completed firm name county well located

LANDOWNER: Jim Jumper  
RT 1 ETTA MS

description of formations encountered	from	to
TOP CLAY	0	20
BLUE CLAY	20	260
CHALK	260	350
NEW ALBANY SAND	350	402

(mailing address)

WELL LOCATION:  
sec. 14 T 8 N R 1 E  
15 miles SW of NEW ALBANY  
(distance) (direction) (nearest town)

WELL PURPOSE:  
(home, irrigation, municipal, industrial)

- WELL COMPLETION DATA:
- (1) diameter (inches) 4"
  - (2) total depth (feet) 402
  - (3) static water level (feet) 60 <sup>below</sup> <sub>above</sub> top of ground.
  - (4) casing PVC 200' (material) (depth)  
4" (size) If telescope see back.
  - (5) screen NONE (length) (depth to top)  
(size) (material)
  - (6) pump 1 10 (HP) (yield gpm)  
FLEC (type power)
  - (7) electric log NO (yes or no)
  - (organization running log)
  - (8) how well bottom plugged OPEN

DRILLERS REMARKS:


RECEIVED

NOV 12 1986

Department of Natural Resources  
Bureau of Land & Water Resources

If well telescopes please sketch and show depths.

GROUND LEVEL

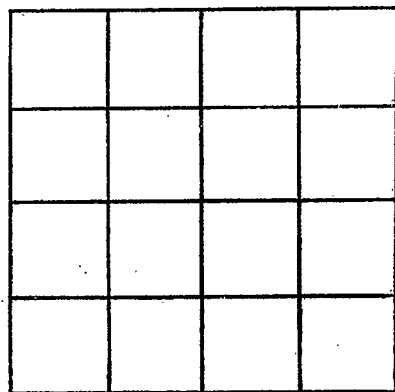

SECTION \_\_\_\_\_

Please indicate well location X.

ADDITIONAL INFORMATION

If more than one screen,  
show locations of each on sketch.