

MISSISSIPPI DEPARTMENT OF NATURAL RESOURCES

Bureau of Land and Water Resources

Southport Mall

P.O. Box 10631

Jackson, Mississippi 39209

WATER WELL DRILLERS LOG

Union
K 2000

JUNE 1987
date well completed

LEEPER Drilling
firm name

Union
county well located

LANDOWNER: Roger Gafford
Pinedale Community
RT1 ET TA MS-
(mailing address)

description of fomations encountered	from	to
<u>TOP CLAY</u>	<u>0</u>	<u>20</u>
<u>BLUE CLAY</u>	<u>20</u>	<u>180</u>
<u>CHALK</u>	<u>180</u>	<u>310</u>
<u>SAND</u>	<u>310</u>	<u>380</u>

WELL LOCATION:
sec. 9 T. 8 N. R. 1 E
9 miles SW of New Albany
(distance) (direction) (nearest town)

WELL PURPOSE: HOME
(home, irrigation, municipal, industrial)

- WELL COMPLETION DATA:
- (1) diameter (inches) 4"
 - (2) total depth (feet) 380 ft
 - (3) static water level (feet) 40 below above top of ground.
 - (4) casing PVC, 200'
(material) (depth)
4" if telescope see back.
(size)
 - (5) screen NONE, -
(length) (depth to top)
(size) (material)
 - (6) pump 1, 15
(HP) (yield gpm)
ELEC
(type power)
 - (7) electric log NO
(yes or no)
(organization running log)
 - (8) how well bottom plugged OPEN

RECEIVED


JUL 17 1987

Department of Natural Resources
Bureau of Land & Water Resources

DRILLERS REMARKS:

If well telescopes please
sketch and show depths.

GROUND LEVEL

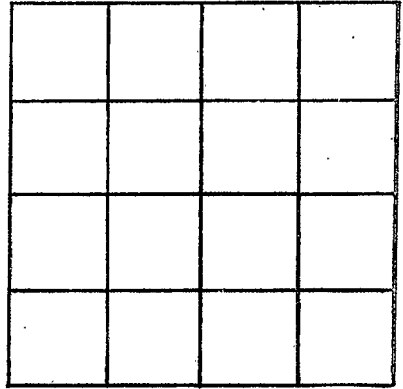

SECTION _____

Please indicate well location X.

ADDITIONAL INFORMATION

If more than one screen,
show locations of each on sketch.