

Union
K
2029

MISSISSIPPI
BOARD OF WATER COMMISSIONERS
416 North State Street
Jackson, Mississippi 39201

WATER WELL DRILLERS LOG

Oct 1989 LEEPER Drilling UNION
date well completed firm name county well located

LANDOWNER: Hugh GATES
RT 1 STTA MS
Pinedale Community
(mailing address)

description of formations encountered	from	to
TOP CLAY	0	20
Red Sand	20	60
BLUE CLAY	60	400
CHALK	400	520
SAND	528	580

WELL LOCATION:
sec. 8 T 8 N R 1 E
3 miles WEST of Pinedale
(distance) (direction) (nearest town)

WELL PURPOSE: HOME
(home, irrigation, municipal, industrial)

WELL COMPLETION DATA:

(1) diameter (inches) 4"

(2) total depth (feet) 580'

(3) static water level (feet) 120' ^{below} top of ground

(4) casing PVC 240' (material) (depth)
4" (size) If telescope see back.

(5) screen NONE (length) (depth to top)

(6) pump 1 (HP) 10 (yield gpm)
slee (type power)

(7) electric log NO (yes or no)

(organization running log)

(8) how well bottom plugged OPEN

RECEIVED


NOV 07 1989

Department of Natural Resources
Bureau of Land & Water Resources

DRILLERS REMARKS:

If well telescopes please sketch and show depths.

GROUND LEVEL

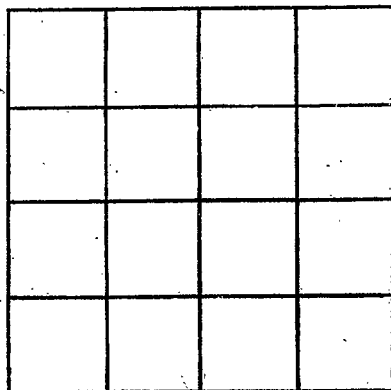

SECTION _____

Please indicate well location X.

ADDITIONAL INFORMATION

If more than one screen,
show locations of each on sketch.