

Union
L 9
12-3-71

MISSISSIPPI
BOARD OF WATER COMMISSIONERS
416 North State Street
Jackson, Mississippi 39201

560.00
for 28.00
588.00

WATER WELL DRILLERS LOG

CODED

12-3-1971 date well completed
J.T. Medlar firm name
Miss county well located

LANDOWNER:	description of formations encountered	from	to
James White	Clay	0	37
Miss Ingomar	Block & Clay	37	160
Miss	Blue	160	226
(mailing address)	Rock & Sand	226	300

WELL LOCATION:
sec. 4 T 8 N R 2 E
4 miles W of Ingomar
(distance) (direction) (nearest town)

WELL PURPOSE:
(home, irrigation, municipal, industrial)

- WELL COMPLETION DATA:
- (1) diameter (inches) 4
 - (2) total depth (feet) 300
 - (3) static water level (feet) 86 below top of ground.
 - (4) casing P 180 (material) (depth)
(size) if telescope see back.
 - (5) screen (length) (depth to top)
(size) (material)
 - (6) pump 1 1/2 6 (HP) (yield gpm)
(type power)
 - (7) electric log (yes or no)
 - (organization running log)
 - (8) how well bottom plugged Open

CODED


JAN 5 1972

MISS. BU. OF WATER COMMISSIONERS

DRILLERS REMARKS:

If well telescopes please sketch and show depths.

GROUND LEVEL

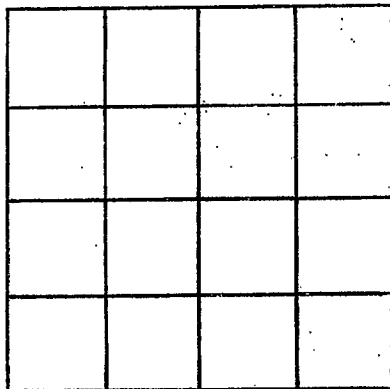

SECTION _____

Please indicate well location X.

ADDITIONAL INFORMATION

If more than one screen, show locations of each on sketch.