

Union
L 10
1-69

MISSISSIPPI
BOARD OF WATER COMMISSIONERS
416 North State Street
Jackson, Mississippi 39201

CODED

CODED

WATER WELL DRILLERS LOG

CODED

1-18
date well completed

1969 Clark Bros
firm name

Union
county well located

LANDOWNER:

W. T. Jackson
ECW
(mailing address)

description of formations encountered

from to

brnls	0	15
Rock & Sand	15	45
Blue mud	45	145
Rock & Sand	145	200

WELL LOCATION:

sec 13 T 8 N R 2 E
4 miles NW of ECW
(distance) (direction) (nearest town)

WELL PURPOSE:

Home
(home, irrigation, municipal, industrial)

WELL COMPLETION DATA:

- (1) diameter (inches) 4"
- (2) total depth (feet) 200'
- (3) static water level (feet) 40' below top of ground.
- (4) casing metal 50'
(material) (depth)
4"
(size) if telescope see back.
- (5) screen None
(length) (depth to top)
(size) (material)
- (6) pump 3 1/2 hp 5
(HP) (yield gpm)
Electric
(type power)
- (7) electric log no
(yes or no)
(organization running log)
- (8) how well bottom plugged no

CODED

CODED


MAR 14 1969

MISS. BD. OF
WATER COM. 2.

DRILLERS REMARKS:

If well telescopes please sketch and show depths.

GROUND LEVEL

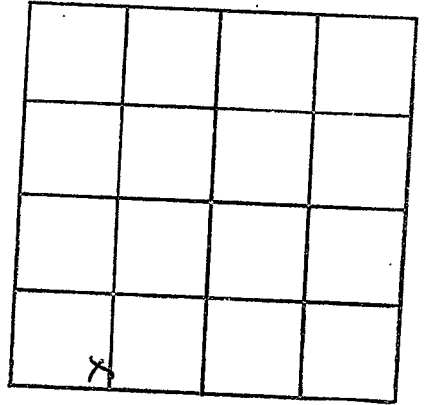

SECTION _____

Please indicate well location X.

ADDITIONAL INFORMATION

If more than one screen, show locations of each on sketch.