

Union Co
L 11
6-69

MISSISSIPPI
BOARD OF WATER COMMISSIONERS
416 North State Street
Jackson, Mississippi 39201

CODED

WATER WELL DRILLERS LOG

CODED

6-14 1969 Clark Bros. Union
date well completed firm name county well located

LANDOWNER:
Jimmie Bradley
Route 4
(mailing address)

description of formations encountered	from	to
shumbo	0	20
Rock + Sand	20	50
blue mud	50	180
Rock + Sand	180	200

WELL LOCATION:
sec. 2 T. 2 N. R. 20 W.
6 miles SW of New Albany
(distance) (direction) (nearest town)

WELL PURPOSE: Home
(home, irrigation, municipal, industrial)

- WELL COMPLETION DATA:
- (1) diameter (inches) 4"
 - (2) total depth (feet) 200
 - (3) static water level (feet) 40 below top of ground.
 - (4) casing metal 84 (material) (depth) 4" (size) If telescope see back.
 - (5) screen None (length) (depth to top)
 - (6) pump 3/4" (HP) 4 (yield gpm) Electric (type power)
 - (7) electric log NO (yes or no)

CODED

(organization running log)
(8) how well bottom plugged NO


AUG 7 1969

DRILLERS REMARKS:

MISS. PD. 22
WATER COMMISSIONERS

If well telescopes please sketch and show depths.

GROUND LEVEL

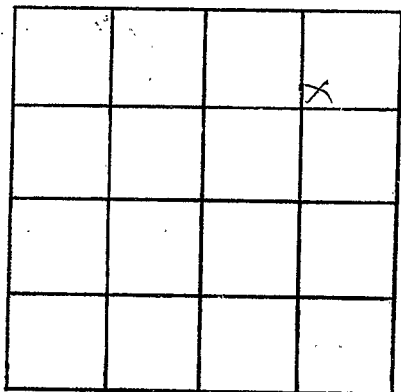

SECTION _____

Please indicate well location X.

ADDITIONAL INFORMATION

If more than one screen,
show locations of each on sketch.