

Union
L12
5-20-69

MISSISSIPPI
BOARD OF WATER COMMISSIONERS
416 North State Street
Jackson, Mississippi 39201

CODED

WATER WELL DRILLERS LOG

CODED

5-20
date well completed

1969 Clark Bros.
firm name

Union
county well located

LANDOWNER:

William Perry
Rt. 1 - New Albany
(mailing address)

description of formations encountered

from to

Red Clay	0	20
Loam & Sand	20	50
Blue Mud	50	130
Rock & Sand	130	200

WELL LOCATION:

sec. 13 T 8 N R 2 E
9 miles S-W of New Albany
(distance) (direction) (nearest town)

WELL PURPOSE:

Home
(home, irrigation, municipal, industrial)

WELL COMPLETION DATA:

- (1) diameter (inches) 4"
- (2) total depth (feet) 200'
- (3) static water level (feet) 30' below top of ground.
- (4) casing Metal 84' (material), (depth)
4" (size) if telescope see back.
- (5) screen None (length) (depth to top)
(size) (material)
- (6) pump 1/2 HP 9 (HP) (yield gpm)
Electric (type power)
- (7) electric log no (yes or no)

(organization running log)

- (8) how well bottom plugged no

DRILLERS REMARKS:


CODED

JUN 2 - 1969

MISS. BD. OF
WATER COMMISSIONERS

If well telescopes please sketch and show depths.

GROUND LEVEL

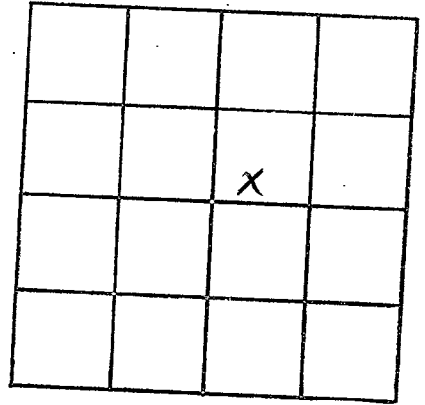

SECTION 13

Please indicate well location X.

ADDITIONAL INFORMATION

Lined area for additional information.

If more than one screen, show locations of each on sketch.