

CODED

UNION
L13
11-1-69

MISSISSIPPI
BOARD OF WATER COMMISSIONERS
416 North State Street
Jackson, Mississippi 39201

WATER WELL DRILLERS LOG

CODED

11-1 1969 Ed Clark Contract Union
date well completed firm name county well located

LANDOWNER: Frank Williamson
Rt one New Albany
(mailing address) MS

WELL LOCATION:
sec. 2 T. 8 N. R. 2 E
9 miles S-W of New Albany
(distance) (direction) (nearest town)

description of formations encountered	from	to
<u>Red Clay</u>	<u>0</u>	<u>20</u>
<u>Rock & Sand</u>	<u>20</u>	<u>24</u>
<u>Blue mud</u>	<u>24</u>	<u>150</u>
<u>Sand</u>	<u>150</u>	<u>200</u>

WELL PURPOSE: Domestic
(home, irrigation, municipal, industrial)

WELL COMPLETION DATA:

(1) diameter (inches) 4"

(2) total depth (feet) 200'

(3) static water level (feet) 30' below above top of ground.

(4) casing Metal, 84',
(material) (depth)
4" if telescope see back.
(size)

(5) screen None
(length) (depth to top)
(size) (material)

(6) pump Kist 4
(HP) (yield gpm)
Electric
(type power)

(7) electric log No
(yes or no)
None
(organization running log)

(8) how well bottom plugged

CODED


DRILLERS REMARKS:

NOV 17 1969

MISS. BD. OF
WATER COMMISSIONERS

If well telescopes please sketch and show depths.

GROUND LEVEL

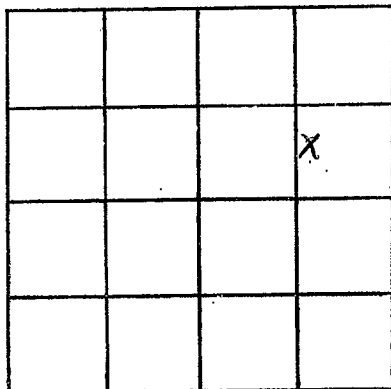

SECTION _____

Please indicate well location X.

ADDITIONAL INFORMATION

If more than one screen,
show locations of each on sketch.