

MISSISSIPPI
BOARD OF WATER COMMISSIONERS
416 North State Street
Jackson, Mississippi 39201

CODED

WATER WELL DRILLERS LOG

Union
L14,
2-7-70

2-7 1970 Clark Bros. Union
date well completed firm name county well located

LANDOWNER:
John Lyton
Rt - 1, New Albany
(mailing address)

description of formations encountered	from	to
<u>Red Clay</u>	<u>0</u>	<u>12</u>
<u>Rock & sand</u>	<u>12</u>	<u>70</u>
<u>blue mud</u>	<u>90</u>	<u>130</u>
<u>Rock & Sand</u>	<u>130</u>	<u>200</u>

WELL LOCATION:
sec. 12 T 3 N R 2 E
7 miles S-W of New Albany
(distance) (direction) (nearest town)

WELL PURPOSE: Home
(home, irrigation, municipal, industrial)

- WELL COMPLETION DATA:
- (1) diameter (inches) 4"
 - (2) total depth (feet) 200'
 - (3) static water level (feet) 35' below top of ground.
 - (4) casing metal, 84'
(material) (depth)
4" if telescope see back.
(size)
 - (5) screen none
(length) (depth to top)
(size) (material)
 - (6) pump 1/2 Sub., 8
(HP) (yield gpm)
Electric
(type power)
 - (7) electric log no
(yes or no)
(organization running log)
 - (8) how well bottom plugged no

CODED


FEB 11 1970

MISS. DD. OF
WATER COMM.

DRILLERS REMARKS:

If well telescopes please sketch and show depths.

GROUND LEVEL

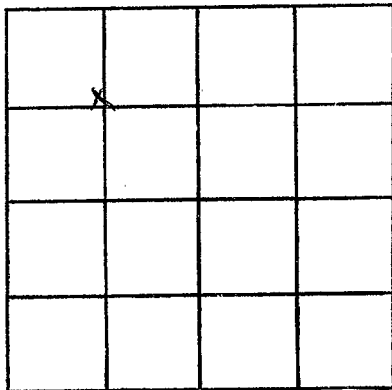

SECTION 12

Please indicate well location X.

ADDITIONAL INFORMATION

If more than one screen, show locations of each on sketch.