

UNION
L 19
3-67

MISSISSIPPI
BOARD OF WATER COMMISSIONERS
416 North State Street
Jackson, Mississippi 39201

CODED

WATER WELL DRILLERS LOG

3-30 1967 date well completed
MCF CARLISLE UNION firm name
county well located

LANDOWNER L. A. BROWNING
NEW ALBANY MISS
R. 4
(mailing address)

description of formations encountered	from	to
<u>GUMBO</u>		
<u>ROCK</u>	<u>23</u>	<u>26</u>
<u>BLUE DIRT</u>	<u>23</u>	<u>73</u>
<u>ROCK</u>	<u>73</u>	<u>175</u>
<u>WATER SAND</u>	<u>175</u>	<u>225</u>
	<u>225</u>	<u>245</u>


WELL LOCATION:
sec. 18 T. 8 N. R. 2 EX
S. K. W.
13 miles SW of NA.
(distance) (direction) (nearest town)

WELL PURPOSE: HOME
(home, irrigation, municipal, industrial)

WELL COMPLETION DATA:

- (1) diameter (inches) 4
- (2) total depth (feet) 1265
- (3) static water level (feet) 12 below above top of ground.
- (4) casing STEEL, 84
(material) (depth)
 If telescope see back.
(size)
- (5) screen ,
(length) (depth to top)
 ,
(size) (material)
- (6) pump 1/2
(HP) (yield gpm)
 (type power)
- (7) electric log NO
(yes or no)
NONE
(organization running log)
- (8) how well bottom plugged

CODED

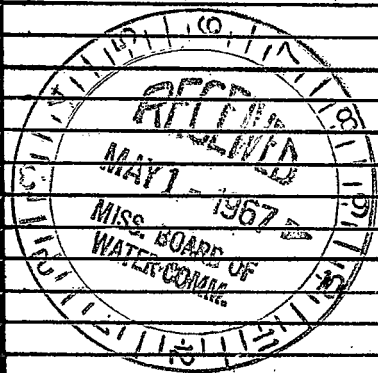

DRILLERS REMARKS:

If well telescopes please sketch and show depths.

GROUND LEVEL

X			

SECTION 18

Please indicate well location X.

ADDITIONAL INFORMATION

If more than one screen, show locations of each on sketch.